2:00

IREDELL COUNTY HEALTH DEPARTMENT

STATESVILLE 704-878-5305 (P) MOORESVILLE 704-664-5281

IMPROVEMENT PERMIT / AUTHORIZATION TO CONSTRUCT / OPERATION PERMIT / EXISTING SYSTEM INSPECTION

PERMIT # 161048 PIN # 4717-56-6612 DATE 9 June 10

OWNER or APPLICANT Bobby Wilcox / Dixieland PHONE/Business cell (704) 202-4971 Home:

OWNER or APPLICANT ADDRESS 146 Cove Gap Rd. Statesville

LOCATION / DIRECTIONS 173 Cove Gap Rd.

SUBDIVISION N/A BLOCK / SECTION LOT # LOT AREA 10+ac. DESIGN FLOW 360 g/d L.T.A.R. 0.3 g/ft²/d

Septic Tank 1000 Gallons: STB 825 Date 2-15-10

Pump Tank Gallons: P T Date

Pump Make Model Serial #

Nitrification Field No Fields 1 No Lines 4 Linear Feet 300

Trench Width 36" Max. Trench Bottom Depth 36" Gravel Depth PA ☑ GRAVITY ☐ PRESSURE

☑ New System ☐ Repair ☐ Expansion System Type I II (III) IV V VI

System Description: 25% Reduction

Repair System Description: 25% Reduction

Maintenance Agreement Required ☐ YES ☑ NO

☑ Residence No. Bedrooms 3

☐ Business No. Persons

☐ Other No. Employees

☐ Slab ☑ Crawl Space


☐ Basement w/plumbing ☐ Basement w/o plumbing

Water Supply ☑ Private - Exist. ☐ Public ☐ Community


Comments / Conditions: Follow contour / Keep 100' from existing well. / Keep house 25'± from existing well.

Comments / Conditions

INITIAL SITE SKETCH

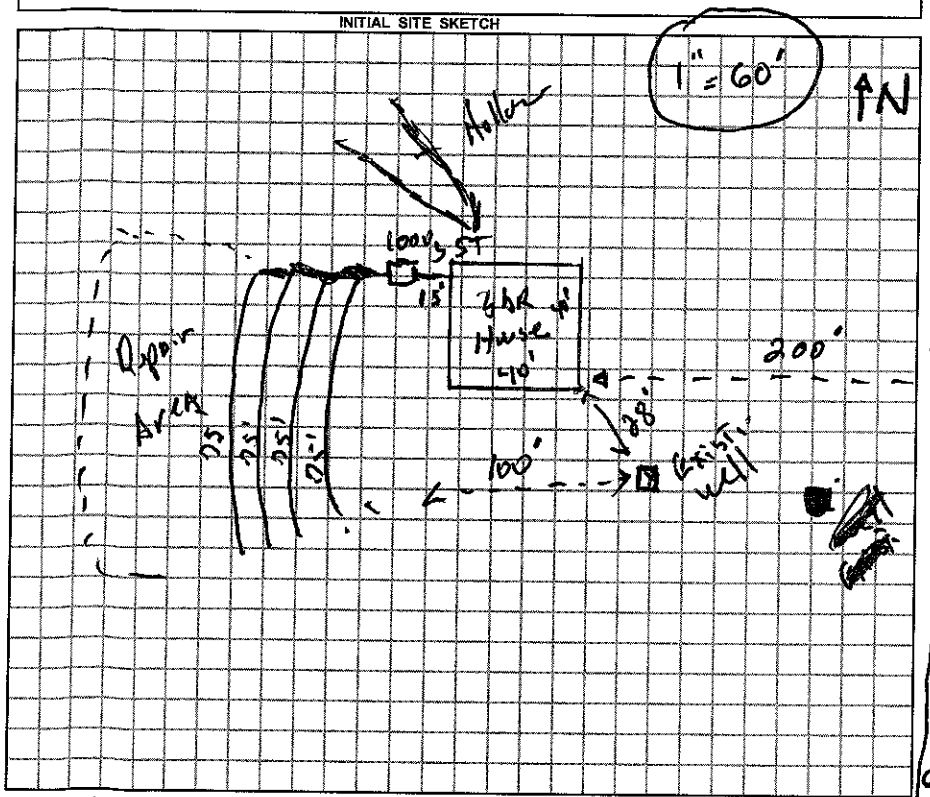

AS BUILT SKETCH

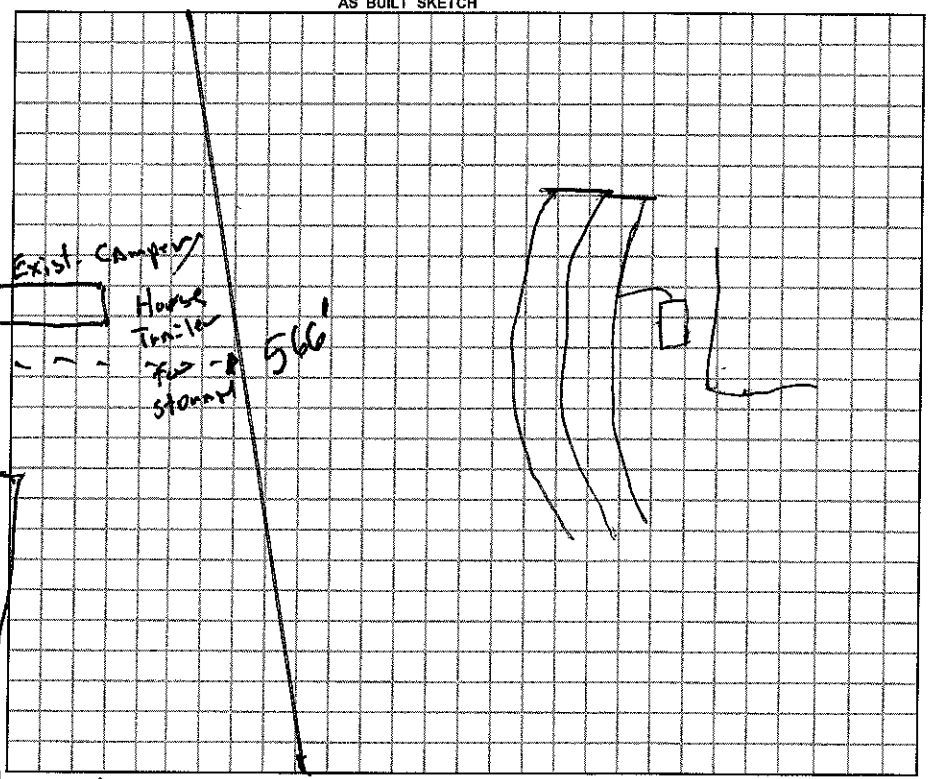

Permit can be suspended or revoked if any false information is supplied toward securing the permit / any unauthorized changes are made to the site / any unauthorized changes are made in the installation of the system.

☐ *IMPROVEMENT PERMIT w / plat valid without expiration.* ☑ *IMPROVEMENT PERMIT w / site plan valid for 60 mos.* ☑ *AUTHORIZATION TO CONSTRUCT valid for period equal to IMPROVEMENT PERMIT-not to exceed 60 mo.*

1283

Owner / Applicant Signature: Bobby Wilcox Date 6-14-10

Improvement Permit by: Date 9 June 10

Authorization to Construct by: Date 9 June 10

Installed by: Rowan Septic

Operation Permit by: Date: 9-1-10

Existing System Inspected by: Date:

YOU SHOULD CONTACT A LOCATOR SERVICE PRIOR TO ANY EXCAVATION.

WHITE COPY Environmental Health YELLOW COPY (Final) Owner / Applicant PINK COPY (Initial) Owner / Applicant