IREDELL COUNTY HEALTH DEPARTMENT

STATESVILLE 704-878-5305 MOORESVILLE 704-664-5281

IMPROVEMENT PERMIT / CERTIFICATE OF COMPLETION / OPERATION PERMIT / EXISTING SYSTEM INSPECTION

PROPERTY DESCRIPTION NO. 19630 DATE 10/26/94 TAX MAP NO. 9P-A-46 (PART)

OWNER OR CONTRACTOR JOHN & RITA BARRINGER PHONE: Business Watershed: ☐ Yes ☒ No

ADDRESS P.O. BOX 147 UNION GROVE, NC 28689 Home 592-4865

LOCATION NC 115 N, TL MIDWAY RD, TR COVE GAP ROAD, TL LONG DRIVEWAY (2nd), BEHIND MH.

SUBDIVISION BLOCK / SECTION LOT 12 LOT AREA 1.9 ACRES SITE CLASS. PS DESIGN FLOW 360 L.T.A.R. 0.35 GPD/FT²

Septic Tank: 1000 Gallons; STB 1012 Date 8/23/94

Pump Tank: Gallons; PT Date

Pump Make: Model Serial No.

Nitrification Field: No Fields 1 Square Feet 1035 Linear Feet 345

No Lines 3 Trench Width 36" Max Trench Bottom Depth 18-36" Gravel Depth 12"

☒ New System ☐ Repair System Type: I, II, III, IV, V, VI

System Description: CONVENTIONAL GRAVITY

Repair System Description: CONVENTIONAL GRAVITY

Maintenance Agreement Required: ☐ Yes ☒ No

☐ House/Mod. Home ☒ Mobile Home ☐ Business ☐ Other

No. Bedrooms 3 No. Bathrooms 2 No. Employees


☐ Slab ☒ Crawl Space ☐ Basement w/plumbing ☐ Basement wo/plumbing

Water Supply: ☒ Individual ☐ Community ☐ Public WELL


Comments: ① KEEP SYSTEM MINIMUM 5' FROM MH FOUNDATION, 10' FROM PROPERTY LINE, 100' FROM WELL ② INSTALL LINES ON CONTOUR AS FLAGGED, NO DEEPER THAN 36" 9' APART IN CENTER.

Comments:

INITIAL SITE SKETCH

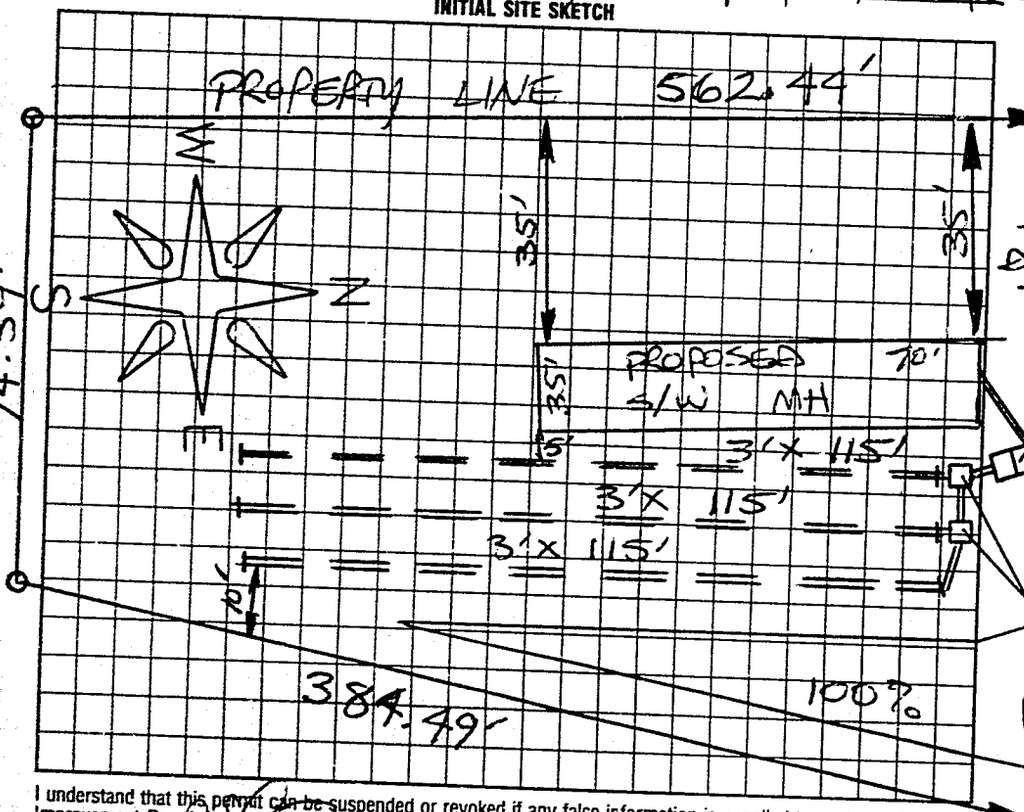

AS BUILT SKETCH

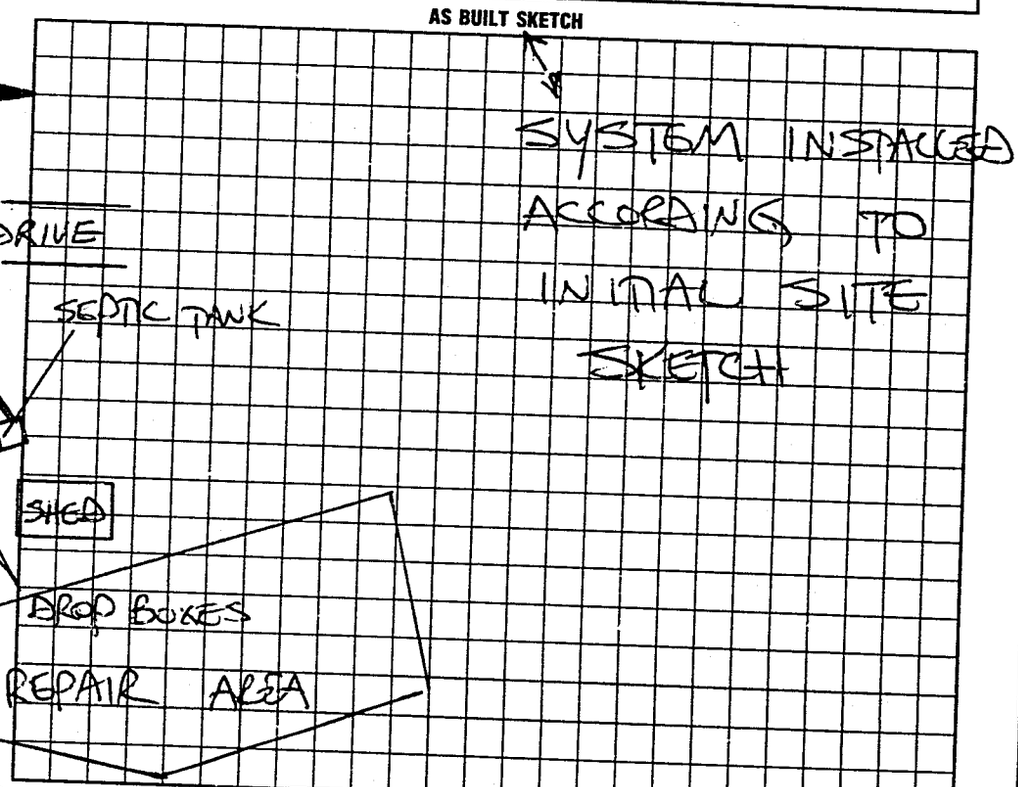

I understand that this permit can be suspended or revoked if any false information is supplied toward securing the permit/any unauthorized changes are made to the site/any unauthorized changes are made in the installation of the system. Improvement Permit is valid for 60 months from date of issuance.

Signed: X Sam Barringer

Improvement Permit by: STEVE HEDRICK date 10/26/94

Existing System Inspection by: date

Installed by: JEFF HURLBUTT JR. HARNESS

Certificate of Completion by: STEVE HEDRICK date 11/4/94

Operation Permit by: date

HEALTH DEPT. COPY: WHITE INSPECTION COPY (FINAL): GREEN OWNER COPY (FINAL): YELLOW INSPECTION COPY (INITIAL): PINK OWNER COPY (INITIAL): GOLD