IREDELL COUNTY HEALTH DEPARTMENT

STATESVILLE 704-878-5305 MOORESVILLE 704-664-5281

IMPROVEMENT PERMIT / CERTIFICATE OF COMPLETION / OPERATION PERMIT / EXISTING SYSTEM INSPECTION

PROPERTY DESCRIPTION NO. 067402 DATE 6-24-97 TAX MAP NO. 4717630421

OWNER OR CONTRACTOR LEMUEL J. JOHNS PHONE: Business Home 878-9058

ADDRESS 274 MONTICELLO ROAD STATESVILLE, NC 28677 Watershed: ☐ Yes ☒ No

LOCATION NC 115 N, TL MIDWAY ROAD 9th LOT ON LEFT PAST LAURA JEANNE DR.

SUBDIVISION MTN. VIEW EST. BLOCK / SECTION LOT 51 LOT AREA 3.13 ACRES SITE CLASS. PS DESIGN FLOW 360 L.T.A.R. 0.33 GPD/FT2

Septic Tank: 1000 Gallons; STB 10 12 Date 7-18-97

Pump Tank: Gallons; PT Date

Pump Make: Model Serial No.

Nitrification Field: No Fields 1 Square Feet 1080 Linear Feet 360

No Lines FOUR Trench Width 36" Max Trench Bottom Depth 30" Gravel Depth 12

☒ New System ☐ Repair System Type: I, II, III, IV, V, VI

System Description: CONVENTIONAL GRAVITY

Repair System Description: CONV. GRAVITY

Maintenance Agreement Required: ☐ Yes ☒ No

☒ House/Mod. Home No. Bedrooms 3

☐ Mobile Home No. Bathrooms 2

☐ Business No. Employees

☐ Other

☐ Slab ☒ Crawl Space ☐ Basement w/plumbing ☐ Basement wo/plumbing


Water Supply: ☒ Individual ☐ Community ~~☐ Public~~ WELL

Comments: KEEP SYSTEM MINIMUM 100' FROM WELL.


Comments:

INITIAL SITE SKETCH

SCALE: 1" = 60'

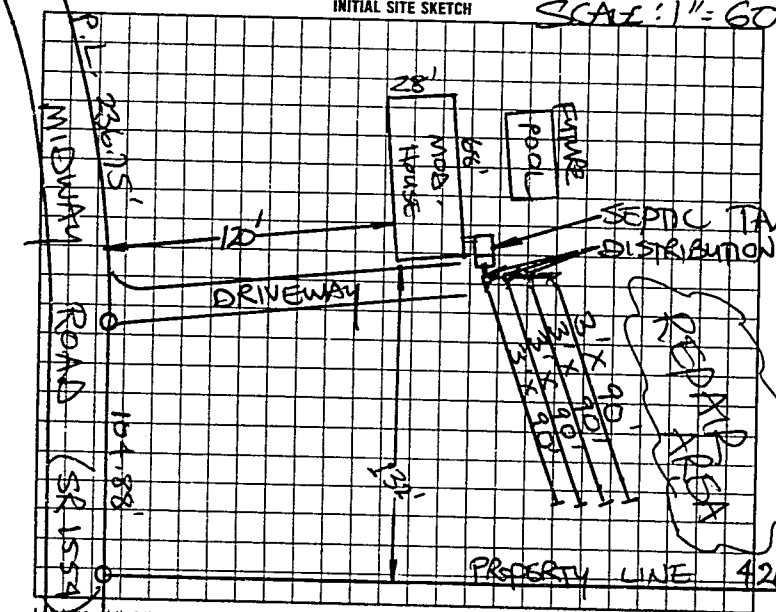

AS BUILT SKETCH

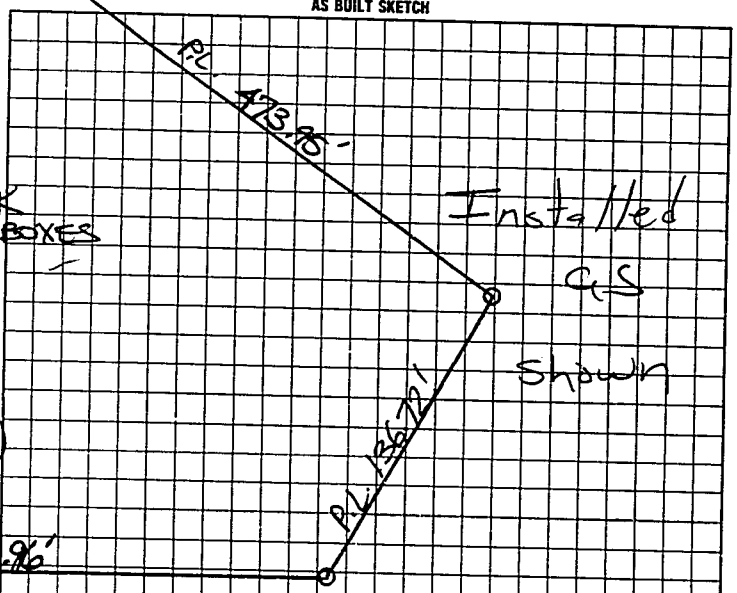

I understand that this permit can be suspended or revoked if any false information is supplied toward securing the permit/any unauthorized changes are made to the site/any unauthorized changes are made in the installation of the system. Improvement Permit is valid for 60 months from date of issuance. AUTHORIZATION TO CONSTRUCT IS VALID FOR 60 MONTHS FROM DATE OF ISSUANCE.

Signed: Lemuel J. Johns

Improvement Permit by: STEVE HEDRICK date 6-24-97

AUTH. TO CONST. ~~Existing System Inspection~~ by: STEVE HEDRICK date 6-24-97

Installed by: Tommy Tyre

~~Certificate of Completion by:~~ date

Operation Permit by: [signature] date 9-23-97

HEALTH DEPT. COPY WHITE INSPECTION COPY (FINAL) GREEN OWNER COPY (FINAL) YELLOW INSPECTION COPY (INITIAL) PINK OWNER COPY (INITIAL) GOLD