# IREDELL COUNTY HEALTH DEPARTMENT

STATESVILLE 704-878-5305 MOORESVILLE 704-664-5281

## IMPROVEMENT PERMIT / AUTHORIZATION TO CONSTRUCT / OPERATION PERMIT / EXISTING SYSTEM INSPECTION

PERMIT# 80608 PIN# 4717 64 9034 DATE 4-28-99

OWNER OR CONTRACTOR Donald Steele PHONE: Business 528 1846 Home

ADDRESS 266 Hoover Rd ~~Statesville~~ Troutman

LOCATION Midway Rd from 115 N on Left Just Past Laura Jeane

SUBDIVISION Mt View Estates BLOCK / SECTION LOT 45 LOT AREA 4+ Ac SITE CLASS IS DESIGN FLOW 360 L.T.A.R. .3

Septic Tank: 1000 Gallons; STB 1012 Date 5 20 99

Pump Tank: Gallons; PT Date

Pump Make: Model Serial No.

Nitrification Field: No Fields 1 Square Feet 1200 Linear Feet 400

No Lines 4 Trench Width 36" Max Trench Bottom Depth 36" Gravel Depth 12+

System Description: Conv Gravity

Repair System Description: Conv Gravity

Maintenance Agreement Required: Yes No

Slab Crawl Space Basement w/plumbing Basement wo/plumbing

House/Mod. Home No. Bedrooms 3

Mobile Home No. Bathrooms 2

Business No. Employees


Other

Water Supply: Individual Public Community WELL


Comments/Conditions: Install Lines on Contour Well Location 100ft From Septic Area

Comments/Conditions:

INITIAL SITE SKETCH

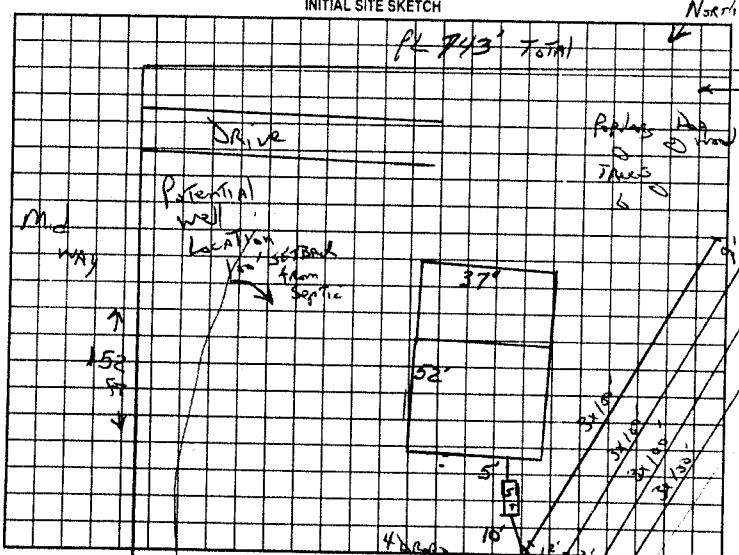


AS BUILT SKETCH

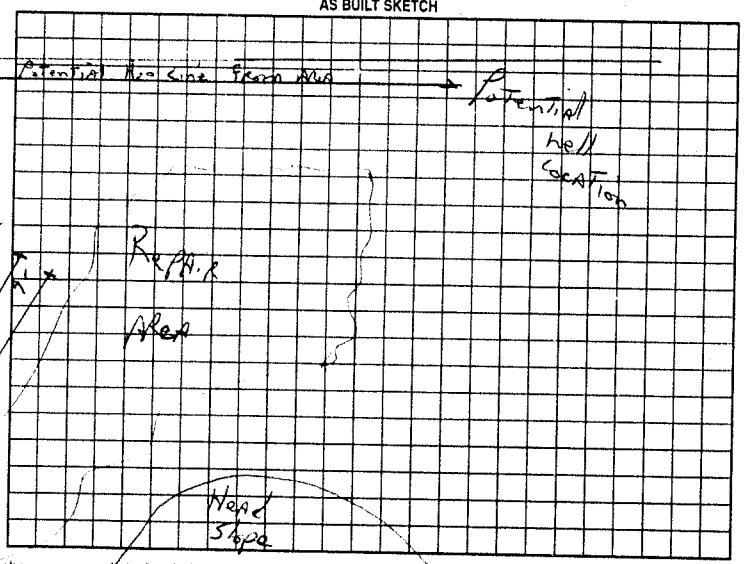


Permit can be suspended or revoked if any false information is supplied toward securing the permit/any unauthorized changes are made to the site/any unauthorized changes are made in the installation of the system. Improvement Permit with plat valid without expiration. Improvement Permit with site plan valid for sixty months. Authorization to Construct is valid for a period equal to that of Improvement Permit – not to exceed sixty months.

Signed: date 4/28/99 Installed by: C+W Backhoe

Improvement Permit by: C Potter date 4-23-99 895' PL →

Authorization to Construct by: C Potter date 4-23-99 Operation Permit by: C Potter date 7.29.99

Existing System Inspection by: date

HEALTH DEPT. COPY: WHITE OWNER COPY (FINAL): YELLOW OWNER COPY (INITIAL): PINK