IREDELL COUNTY HEALTH DEPARTMENT

STATESVILLE 704-878-5305 MOORESVILLE 704-664-5281

IMPROVEMENT PERMIT / CERTIFICATE OF COMPLETION / OPERATION PERMIT / EXISTING SYSTEM INSPECTION

PROPERTY DESCRIPTION NO. 19378 DATE 9/14/94 TAX MAP NO. 9P-A-46 (PART OF) Watershed: ☐ Yes ☑ No

OWNER OR CONTRACTOR RITA BARRINGER PHONE: Business Home 592-4865

ADDRESS P.O. BOX 147 UNION GROVE, NC 28689

LOCATION NC 115 N, TL MIDWAY RD, TR COVE GAP RD, TL 2ND DRIVEWAY BACK OFF ROAD ~800'

SUBDIVISION BLOCK / SECTION LOT LOT AREA ACREAGE SITE CLASS. PS DESIGN FLOW 360 L.T.A.R. 0.35 GPD/FT²

Septic Tank: 1000 Gallons; STB 1012 Date 8/29/94

Pump Tank: Gallons; PT Date

Pump Make. Model Serial No.

Nitrification Field: No Fields 1 Square Feet 1035 Linear Feet 345

No Lines 3 Trench Width 36" Max Trench Bottom Depth 18-36" Gravel Depth 12"

☑ New System ☐ Repair System Type: I (II) III, IV, V, VI

System Description: CONVENTIONAL GRAVITY

Repair System Description: CONV. GRAVITY

Maintenance Agreement Required: ☐ Yes ☑ No

☐ House/Mod. Home ☑ Mobile Home ☐ Business ☐ Other

No. Bedrooms 3 No. Bathrooms 2 No. Employees


☐ Slab ☑ Crawl Space ☐ Basement w/plumbing ☐ Basement wo/plumbing

Water Supply: ☑ Individual ☐ Community ☐ Public WELL

Comments: (1) KEEP SYSTEM MINIMUM 5' FROM MH, 10' FROM PROPERTY LINE, 100' FROM WELL (2) INSTALL LINES ON CONTOUR, NO DEEPER THAN 36", 9' APART MINIMUM ON CENTER

Comments:

INITIAL SITE SKETCH

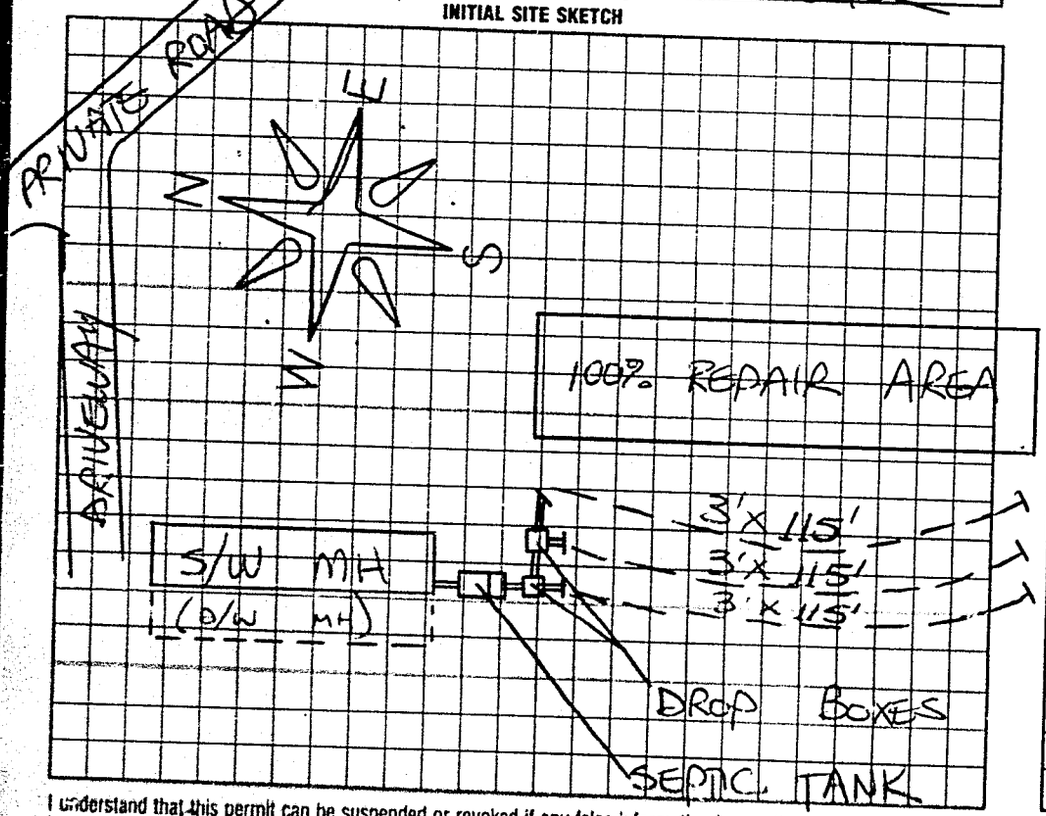

AS BUILT SKETCH

SYSTEM INSTALLED ACCORDING TO INITIAL SITE SKETCH

I understand that this permit can be suspended or revoked if any false information is supplied toward securing the permit/any unauthorized changes are made to the site/any unauthorized changes are made in the installation of the system. Improvement Permit is valid for 60 months from date of issuance.

Signed: X Jonathan M. Barringer

Improvement Permit by: STEVE HEDRICK date 9/14/94

Existing System Inspection by: date

Installed by: JEFF HURLBUT / JR. HARTNESS

Certificate of Completion by: STEVE HEDRICK date 11/15/94

Operation Permit by: date

HEALTH DEPT. COPY: WHITE INSPECTION COPY (FINAL) GREEN OWNER COPY (FINAL) YELLOW INSPECTION COPY (INITIAL) PINK OWNER COPY (INITIAL): GOLD