IREDELL COUNTY HEALTH DEPARTMENT

STATESVILLE 704-878-5305 MOORESVILLE 704-664-5281

IMPROVEMENT PERMIT / AUTHORIZATION TO CONSTRUCT / OPERATION PERMIT / EXISTING SYSTEM INSPECTION

PERMIT# 104507 PIN# 4719-74-0935

OWNER OR CONTRACTOR Haydon B. "Tim" Hamby PHONE: Business (704) 872-0925 Home — DATE 2/4/02

ADDRESS 906 Old Mocksville Rd Statesville, N.C. 28625

LOCATION Hwy 115 N Q on Midway, past Coe Cap Rd corner of Laura Jane + Midway Rd.

SUBDIVISION Mtn. View Estates BLOCK / SECTION — LOT 11 LOT AREA 1.18 Ac. SITE CLASS P3 DESIGN FLOW 360 L.T.A.R. .30

Septic Tank: 1,000 Gallons: STB 1612 Date 2-20-02
Pump Tank: — Gallons: PT — Date —
Pump Make: — Model — Serial No. —
Nitrification Field: No Fields 1 Square Feet 1200 Linear Feet 400
No Lines 4 Trench Width 36" Max Trench Bottom Depth 30"

X New System ☐ Repair System Type: ☐ II. III. IV. V. VI
System Description: Conv. Gravity
Repair System Description Conv. 25% Reduction
Maintenance Agreement Required: ☐ Yes X No
Gravel Depth 12"


X House/Mod. Home No. Bedrooms 3
☐ Mobile Home No. Bathrooms 2
☐ Business No. Employees —
☐ Other —
☐ Slab X Crawl Space ☐ Basement w/plumbing ☐ Basement wo/plumbing

Water Supply: X Individual ☐ Public ☐ Community


Comments/Conditions: ① Pot. well site ② Install Inlet on Contour ③ Key 100' from Septa System Proper Setbacks

Comments/Conditions: -Polyblok Filter Installed -S.T. Marker Installed.

INITIAL SITE SKETCH

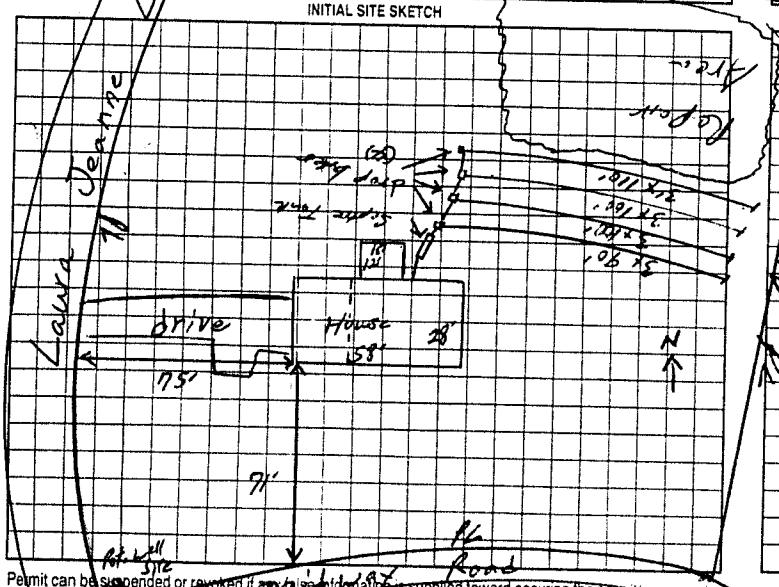

AS BUILT SKETCH

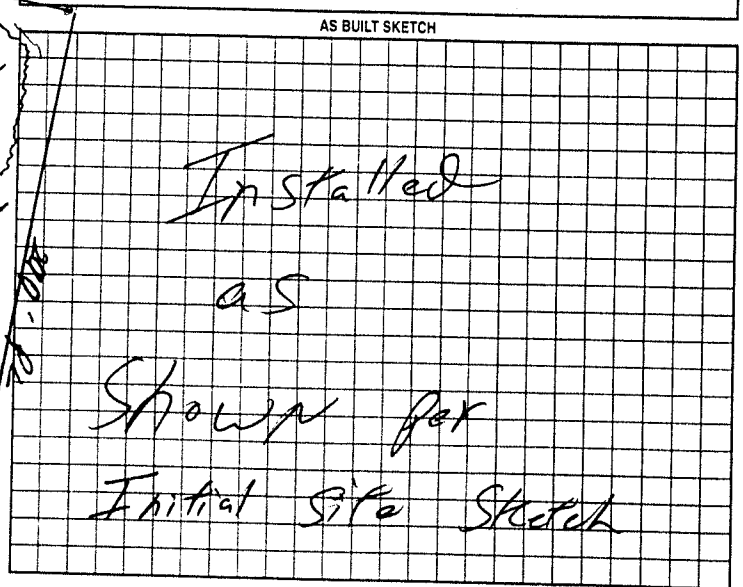

Permit can be suspended or revoked if any false information is supplied toward securing the permit, any unauthorized changes are made to the site, any unauthorized changes are made in the installation of the system. Improvement Permit with plat valid without expiration. Improvement Permit with site plan valid for sixty months. Authorization to Construct is valid for a period equal to that of Improvement Permit – not to exceed sixty months.

Signed: Haydon Hamby Jr date 2/3/02 Installed by: Craig Thompson

Improvement Permit by: Willian O. Johnson date 2/11/02 Operation Permit by: Willian O. Johnson date 7/5/02

Authorization to Construct by: Willian O. Johnson date 2/11/02 Existing System Inspection by: — date —

HEALTH DEPT. COPY WHITE OWNER COPY (FINAL) YELLOW OWNER COPY (INITIAL) PINK