IREDELL COUNTY HEALTH DEPARTMENT

STATESVILLE 704-878-5305 MOORESVILLE 704-664-5281

IMPROVEMENT PERMIT / AUTHORIZATION TO CONSTRUCT / OPERATION PERMIT / EXISTING SYSTEM INSPECTION

PERMIT# 077852 PIN# 4717 74 3404 DATE 12-3-98

OWNER OR CONTRACTOR Ross Moore PHONE: Business 873-3673 Home (704) 873-9811

ADDRESS 5664 GREENWAY DRIVE, STATESVILLE, NC 28677

LOCATION NC 115 NORTH, TL MIDWAY ROAD, 3RD LOT ON LEFT PAST COVE GAP ROAD.

SUBDIVISION MTN. VIEW EST BLOCK / SECTION LOT 41 LOT AREA 1.03 ACRES SITE CLASS PS DESIGN FLOW 480 L.T.A.R. 0.30 GPD/FT²

Septic Tank: 1000 Gallons; STB LW2 Date 4-24-99
Pump Tank: Gallons; PT Date
Pump Make: Model Serial No.
Nitrification Field: No Fields 1 Square Feet 1600 Linear Feet 540
No Lines SIX Trench Width 36" Max Trench Bottom Depth 36" Gravel Depth 12"

✓ New System Repair System Type I II III IV V
System Description CONVENTIONAL GRAVITY
Repair System Description CONV. GRAV/PUMP
Maintenance Agreement Required Yes No
Slab Crawl Space Basement w/plumbing Basement w/o plumbing


✓ House/~~Mod. Home~~ No. Bedrooms 4
Mobile Home No. Bathrooms 2
Business No. Employees
Other

Water Supply: ✓ Individual ☐ Public ☐ Community WELL

Comments/Conditions: KEEP SYSTEM MINIMUM 100 FEET FROM WELL

Comments/Conditions

INITIAL SITE SKETCH SCALE: 1" = 50'

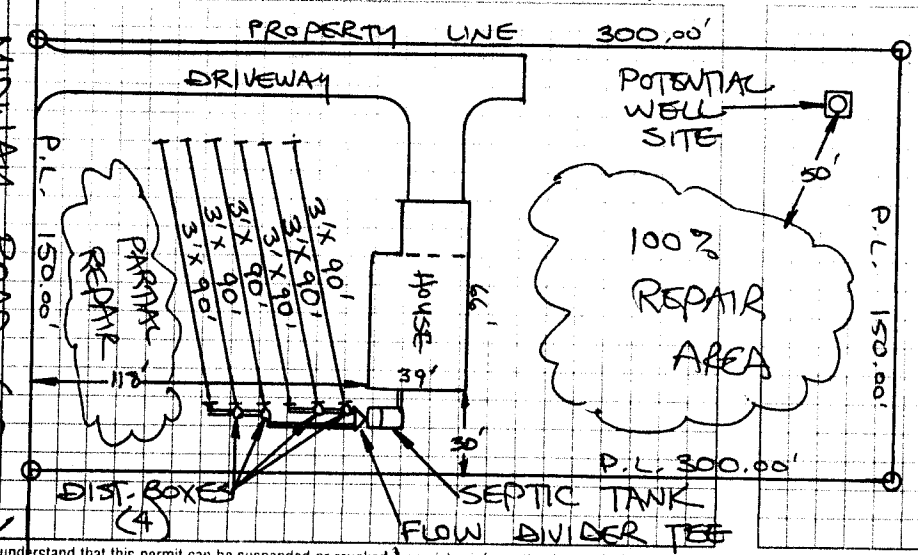

AS BUILT SKETCH

Installed as shown

I understand that this permit can be suspended or revoked if any false information is supplied toward securing the permit/any unauthorized changes are made to the site/any unauthorized changes are made in the installation of the system. Improvement Permit with plat valid without expiration. Improvement Permit with site plan valid for sixty months. Authorization to Construct is valid for a period equal to that of Improvement Permit – not to exceed sixty months.

Signed: Ross a Moore date 12-3-98

Improvement Permit by: STEVE HEDRICK date 12-3-98

Authorization to Construct by: STEVE HEDRICK date 12-3-98

Installed by: A-1 Backhoe

Operation Permit by: [illegible] RS date 6-11-99

Existing System Inspection by: date

HEALTH DEPT. COPY: WHITE INSPECTION COPY (FINAL): GREEN OWNER COPY (FINAL): YELLOW INSPECTION COPY (INITIAL): PINK OWNER COPY (INITIAL): GOLD