# IREDELL COUNTY HEALTH DEPARTMENT

STATESVILLE 704-878-5305 MOORESVILLE 704-664-5281

## IMPROVEMENT PERMIT / AUTHORIZATION TO CONSTRUCT / OPERATION PERMIT / EXISTING SYSTEM INSPECTION

PERMIT# 090087 PIN# 4717 75 1297 DATE 6-26-2000

OWNER OR CONTRACTOR STATESVILLE HOUSING PHONE: Business 924-9393 Home

ADDRESS 115 MOREHEAD ROAD, STATESVILLE, NC 28677

LOCATION NC 115 N, TL MIDWAY RD, TL LAURA JEANNE LN 4TH LOT ON RIGHT

SUBDIVISION MTN. VIEW EST BLOCK / SECTION LOT 20 LOT AREA 1.00 ACRE SITE CLASS PS' DESIGN FLOW 360 L.T.A.R. 0.25 GPD/FT²

Septic Tank: 1000 Gallons; STB 4/12 00 Date 10/12

Pump Tank: Gallons; PT Date

Pump Make: Model Serial No.

Nitrification Field: No Fields 1 Square Feet 1440 Linear Feet 480

No Lines SIX Trench Width 36" Max Trench Bottom Depth 36" Gravel Depth 12"

☑ New System ☐ Repair System Type: I, II, III, IV, V, VI

System Description: CONVENTIONAL GRAVITY

Repair System Description: CONV. GRAVITY

Maintenance Agreement Required: ☐ Yes ☑ No

☑ House/Mod. Home No. Bedrooms 3

☐ Business No. Bathrooms 2

☐ Other No. Employees

☐ Slab ☑ Crawl Space ☐ Basement w/plumbing ☐ Basement wo/plumbing


Water Supply: ☑ Individual ☐ Public ☐ Community

WELL

Comments/Conditions: ① KEEP SYSTEM MINIMUM 100 FEET FROM WELL ② USE ONE FLOW DIVIDER TEE TO ACHIEVE EQUAL DISTRIBUTION INTO TWO DIST. BOXES FEEDING THREE LINES EACH.

Comments/Conditions

INITIAL SITE SKETCH

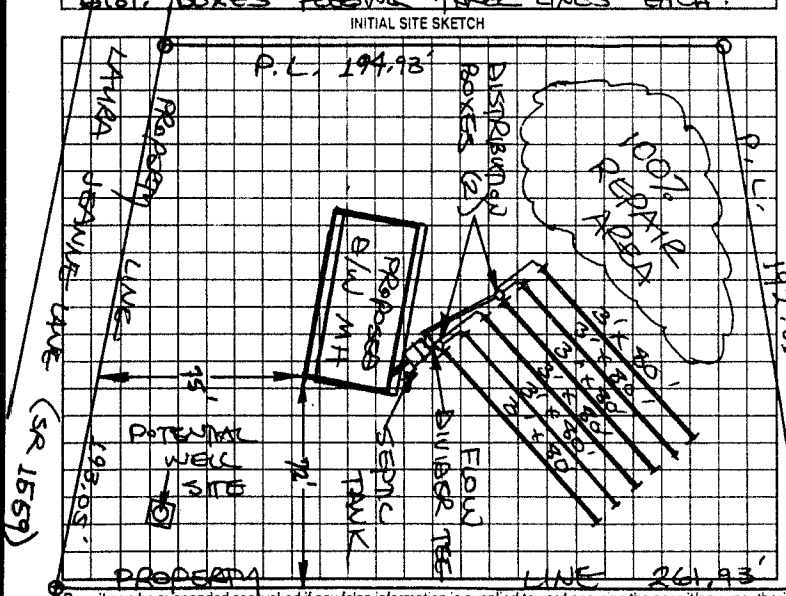


AS BUILT SKETCH

Distribution Boxes Check System installed As Designed

Permit can be suspended or revoked if any false information is supplied toward securing the permit/any unauthorized changes are made to the site/any unauthorized changes are made in the installation of the system. Improvement Permit with plat valid without expiration. Improvement Permit with site plan valid for sixty months. Authorization to Construct is valid for a period equal to that of Improvement Permit – not to exceed sixty months.

Signed: Richard B. Mulch date 6/00/2000 Installed by: Craig Thompson

Improvement Permit by: STEVE HEDRICK date 6-26-2000 Operation Permit by: [signature] date July 19 2000

Authorization to Construct by: STEVE HEDRICK date 6-26-2000 Existing System Inspection by: date

HEALTH DEPT. COPY: WHITE OWNER COPY (FINAL): YELLOW OWNER COPY (INITIAL): PINK