IREDELL COUNTY HEALTH DEPARTMENT

STATESVILLE 704-878-5305 MOORESVILLE 704-664-5281

IMPROVEMENT PERMIT / CERTIFICATE OF COMPLETION / OPERATION PERMIT / EXISTING SYSTEM INSPECTION

PROPERTY DESCRIPTION NO. 065595 DATE 4-10-97 TAX MAP NO. 4717753649 Watershed: ☐ Yes ☑ No

OWNER OR CONTRACTOR T. PLUMLEY PHONE: Business 322-3911 Home 466-2111

ADDRESS RT. 3 BOX 538 CONOVER, NC 28613

LOCATION NC 115 N, TL MIDWAY RD, TR COVE GAP ROAD, ON LEFT AT LAURA JEANNE LANE

SUBDIVISION MTN VIEW EST BLOCK / SECTION ____ LOT 22 LOT AREA 1.25 AC SITE CLASS. BS DESIGN FLOW 360 L.T.A.R. 0.30 GPD/FT²

Septic Tank: 1000 Gallons; STB 1012 Date 2-26-97

Pump Tank: ____ Gallons; PT ____ Date ____

Pump Make: ____ Model ____ Serial No. ____

Nitrification Field: No. Fields 1 Square Feet 1200 Linear Feet 400

No Lines 5 ~~Trench~~ Trench Width 36" Max Trench Bottom Depth 36" Gravel Depth 12"

☑ New System ☐ Repair System Type: I, II, III, IV, V, VI

System Description: CONV. GRAVITY

Repair System Description: CONV. GRAVITY/Pump

Maintenance Agreement Required: ☐ Yes ☑ No

☐ Slab ☑ Crawl Space ☐ Basement w/plumbing ☐ Basement wo/plumbing

☑ House/Mod. Home No. Bedrooms 3

☐ Mobile Home No. Bathrooms 3

☐ Business No. Employees ____


☐ Other ____

Water Supply: ☑ Individual ☐ Community ☐ Public WELL


Comments: KEEP SYSTEM MINIMUM 100' FROM WELL

Comments:

INITIAL SITE SKETCH

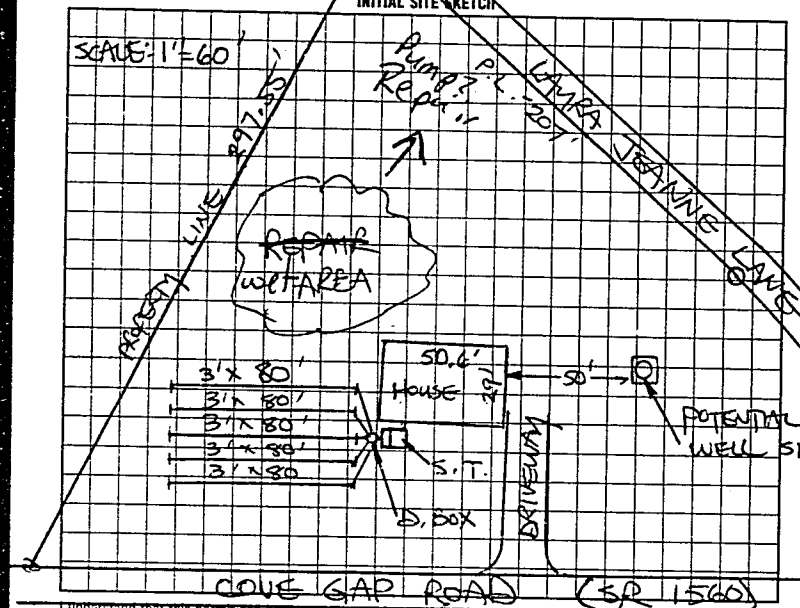

AS BUILT SKETCH

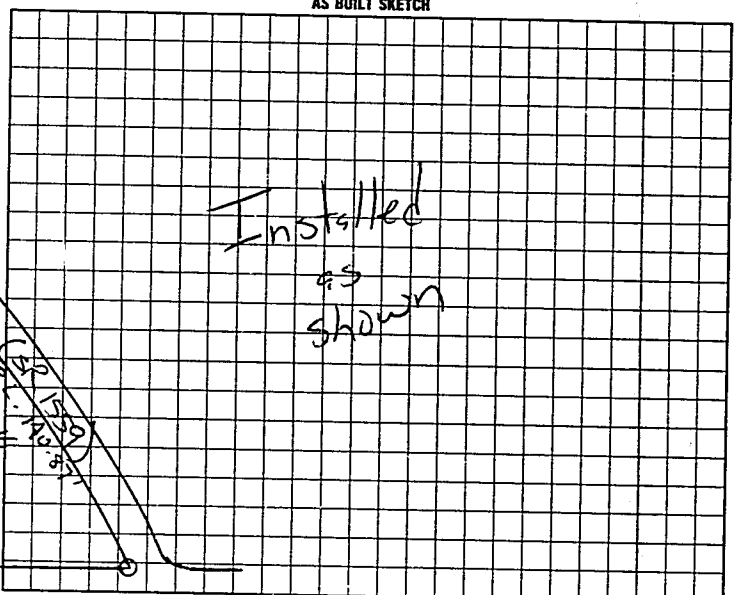

I understand that this permit can be suspended or revoked if any false information is supplied toward securing the permit any unauthorized changes are made to the site/any unauthorized changes are made in the installation of the system. AUTHORIZATION TO CONSTRUCT IS VALID FOR 60 MONTHS FROM ISSUE

Signed: ~~[illegible]~~ + Paul Iannello Plumber

Improvement Permit by: STEVE HEARICK date 4-10-97

Existing System Inspection by: STEVE HEARICK date 4-10-97

Installed by: Barry Sigmon

~~Certificate of Completion by:~~ ____ date ____

Operation Permit by: Mark C. Ott RS date 4-30-97

HEALTH DEPT COPY: WHITE INSPECTION COPY (FINAL): GREEN OWNER COPY (FINAL): YELLOW INSPECTION COPY (INITIAL): PINK OWNER COPY (INITIAL): GOLD

9622200