IREDELL COUNTY HEALTH DEPARTMENT

STATESVILLE 704-878-5305 MOORESVILLE 704-664-5281

IMPROVEMENT PERMIT / AUTHORIZATION TO CONSTRUCT / OPERATION PERMIT / EXISTING SYSTEM INSPECTION

PERMIT# 089233 PIN# 4717 78 2368 DATE 5-16-00

OWNER OR CONTRACTOR ROGER HILL PHONE: Business Home (315) 363-6199

ADDRESS 4510 WILLIAMS ST. SHERRILL, NY 13461

LOCATION NC 115 N, TL MIDWAY ROAD, TR COVE GAP ROAD PS 0.7 MILE ON LEFT

SUBDIVISION BLOCK / SECTION LOT LOT AREA 10.51 ACRES SITE CLASS PS DESIGN FLOW 480 L.T.A.R. 0.30 GPD/FT²

Septic Tank: 1000 Gallons, STB 825 Date 3-11-00
Pump Tank: Gallons, PT Date
Pump Make: Model Serial No.
Nitrification Field: No Fields 1 Square Feet 1600 Linear Feet 540
No Lines SIX Trench Width 36" Max Trench Bottom Depth 36"

☑ New System ☐ Repair System Type: I II III IV V VI
System Description: CONVENTIONAL GRAVITY
Repair System Description: CONV. GRAVITY
Maintenance Agreement Required: ☐ Yes ☑ No
Gravel Depth 12" ☐ Slab ☑ Crawl Space ☐ Basement w/plumbing ☐ Basement wo/plumbing


☐ House/Mod. Home No. Bedrooms 4
☑ Mobile Home No. Bathrooms 2
☐ Business No. Employees
☐ Other

Water Supply: ☑ Individual ☐ Public ☐ Community WELL


Comments./Conditions: ① KEEP SYSTEM MINIMUM 100 FEET FROM WELL ② USE ONE FLOW DIVIDER TEE TO ACHIEVE EQUAL DISTRIBUTION INTO TWO SETS OF DROP BOXES FEEDING THREE LINES IN EACH SUBFIELD.

Comments./Conditions: SEPTIC TANK W/ RISERS & MARKER INSTALLED USING "POLYLOK" FILTER.

INITIAL SITE SKETCH

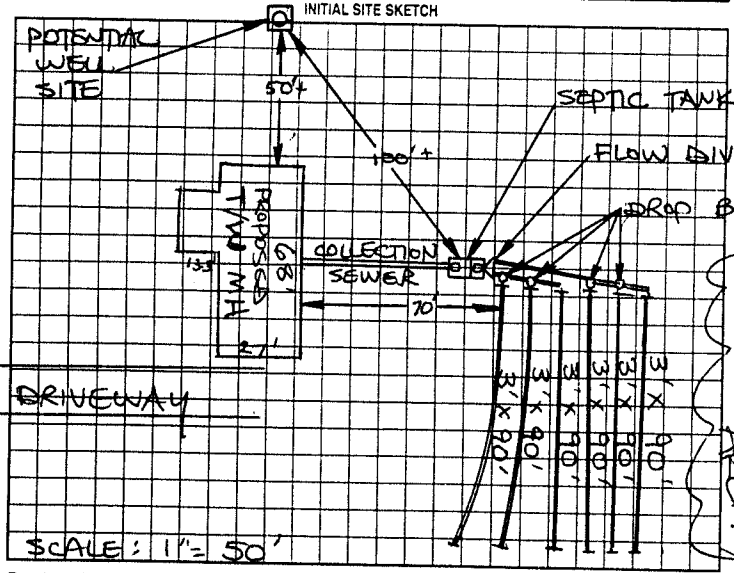

AS BUILT SKETCH

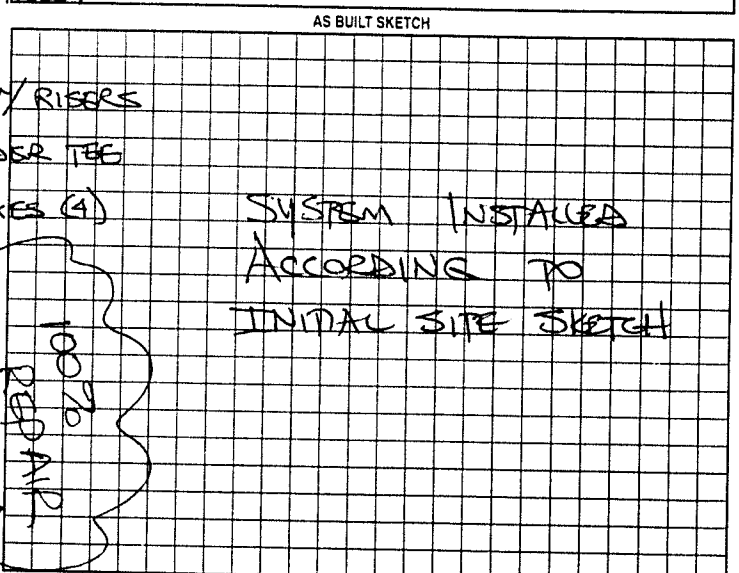

Permit can be suspended or revoked if any false information is supplied toward securing the permit/any unauthorized changes are made to the site/any unauthorized changes are made in the installation of the system. Improvement Permit with plat valid without expiration. Improvement Permit with site plan valid for sixty months. Authorization to Construct is valid for a period equal to that of Improvement Permit – not to exceed sixty months.

Signed: _____ date 5-16-00 Installed by: RANDY MELTON, PIEDMONT SEPTIC TANK

Improvement Permit by: STEVE HEDRICK date 5-16-00 Operation Permit by: STEVE HEDRICK date 5-23-00

Authorization to Construct by: STEVE HEDRICK date 5-16-00 Existing System Inspection by: _____ date _____

HEALTH DEPT. COPY. WHITE OWNER COPY (FINAL). YELLOW OWNER COPY (INITIAL). PINK