IREDELL COUNTY HEALTH DEPARTMENT

STATESVILLE 704-878-5305 MOORESVILLE 704-664-5281

IMPROVEMENT PERMIT / AUTHORIZATION TO CONSTRUCT / OPERATION PERMIT / EXISTING SYSTEM INSPECTION

PERMIT# 76381 PIN# 4717 83 0684 DATE 9-17-98

OWNER OR CONTRACTOR Guadalupe Jacquez PHONE: Business _____ Home 876 2847

ADDRESS 647 midway Dr. Statesville, N.C.

LOCATION 115N TL midway Dr. before Core Craft Rd left.

SUBDIVISION Mt. View Est. BLOCK / SECTION _____ LOT 33 LOT AREA 1.12 SITE CLASS RS DESIGN FLOW 360 L.T.A.R. 1.3

Septic Tank: 1000 Gallons; STB 1012 Date 5-1-99
Pump Tank: _____ Gallons; PT _____ Date _____
Pump Make: _____ Model _____ Serial No. _____
Nitrification Field: No Fields 1 Square Feet 1200 Linear Feet 400
No Lines 5 Trench Width 36" Max Trench Bottom Depth 36" Gravel Depth 12"

☑ New System ☐ Repair System Type: I ☐ II, ☐ III, ☐ IV, ☐ V, ☐ VI
System Description: Conv. Gravity
Repair System Description: Pump to Conv.
Maintenance Agreement Required: ☐ Yes ☑ No
☐ Slab ☑ Crawl Space ☐ Basement w/plumbing ☐ Basement wo/plumbing


☑ House/Mod. Home No. Bedrooms 3
☐ Mobile Home No. Bathrooms 2
☐ Business No. Employees ____
☐ Other _____

Water Supply:
☑ Individual
☐ Public
☐ Community


Comments:/Conditions:

Comments:/Conditions:
Installed as shown

INITIAL SITE SKETCH 302

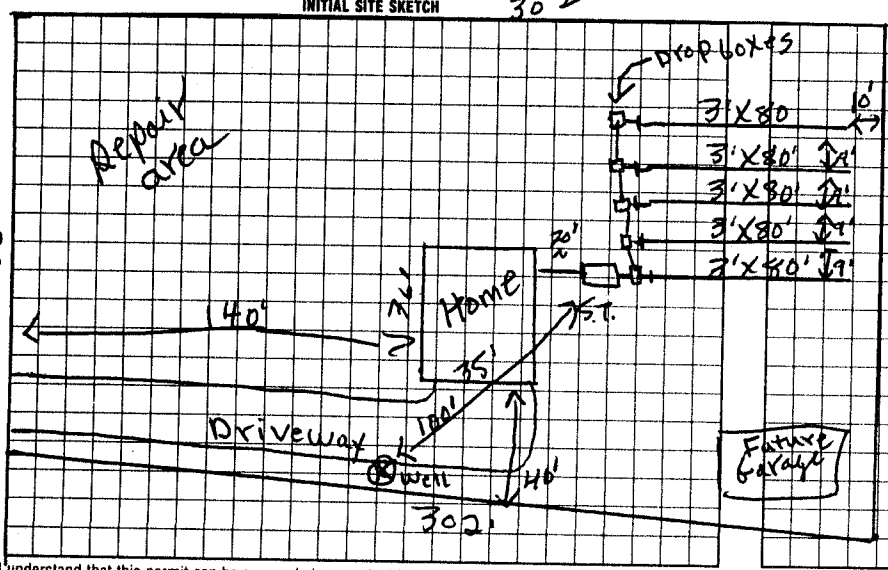

AS BUILT SKETCH

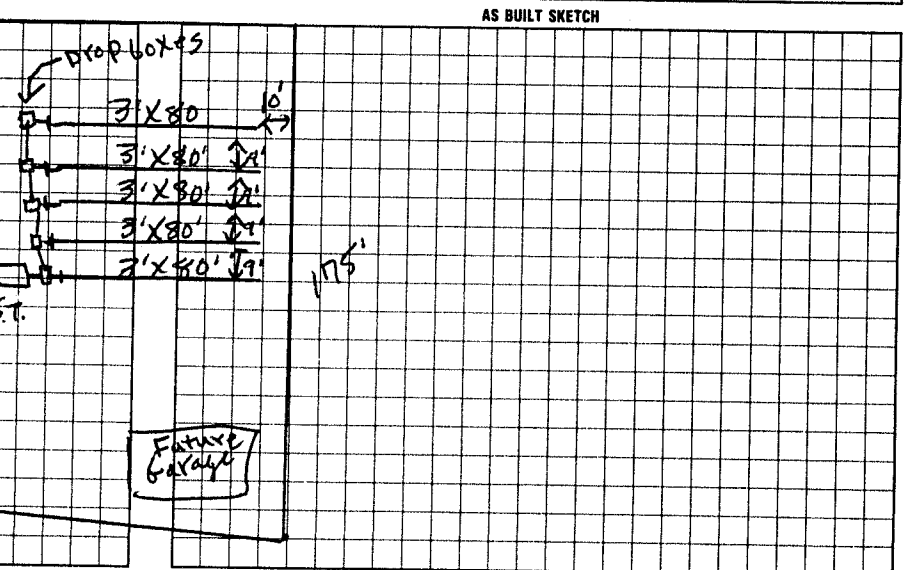

I understand that this permit can be suspended or revoked if any false information is supplied toward securing the permit/any unauthorized changes are made to the site/any unauthorized changes are made in the installation of the system. Improvement Permit with plat valid without expiration. Improvement Permit with site plan valid for sixty months. Authorization to Construct is valid for a period equal to that of Improvement Permit – not to exceed sixty months.

Signed: Guadalupe Jacquez date _____ Installed by: Steve Jaden

Improvement Permit by: D.C. Moore date 9-17-98 Operation Permit by: Mat C.O.J. RS date 7-19-99

Authorization to Construct by: D.C. Moore date 9-17-98 Existing System Inspection by: _____ date _____

HEALTH DEPT. COPY WHITE | INSPECTION COPY (FINAL) GREEN | OWNER COPY (FINAL) YELLOW | INSPECTION COPY (INITIAL) PINK | OWNER COPY (INITIAL) GOLD