L COUNTY HEALTH DEPARTMENT

Statesville Office (704) 878-5305 Mooresville Office (704) 660-3625 PERMIT # 212404

IENT PERMIT / AUTHORIZATION TO CONSTRUCT / OPERATION PERMIT / EXISTING SYSTEM

PIN # 4717833971

Blue Ridge Pools — APPLICANT ADDRESS: 827 Poplar Springs Rd.

S: 664 Midway Rd. — PHONE: 704-902-8489 ALT. PHONE: N/A

SITE DIRECTIONS: Hwy 115 N TL Midway Rd. Property on Right

SUBDIVISION: N/A — SECTION: N/A LOT # N/A LOT AREA: 2.72 acres DESIGN FLOW: Existing L.T.A.R.: Existing

Septic Tank	Existing (gal)	STB		Date			
Pump Tank	(gal)	PT		Date			
Pump Make		Model		Serial #			
# Nitrification Fields	Ex	# Lines	Ex	Linear Ft:	Ex		
Trench Width	Ex	Max. Trench Bottom Depth	Ex	Gravel Depth	Ex		

☐ New System ☐ Repair ☐ Expansion System Type: I (II) III IV V VI

System Description: Existing

Repair System Description:

Maintenance Agreement Required: ☐ YES ☑ NO

☐ GRAVITY ☐ PRESSURE

☑ Residence — No. Bedrooms: Ex

☐ Business — No. Persons: Ex

☐ Other — No. Employees:

☐ Slab ☑ Crawl Space


☐ Basement w/plumbing ☐ Basement w/o plumbing

Water Supply: ☑ Private ☐ Public ☐ Community


Comments / Conditions:

- Maintain a minimum of 15' between proposed Pool & all components of septic tank system.

INITIAL SITE SKETCH

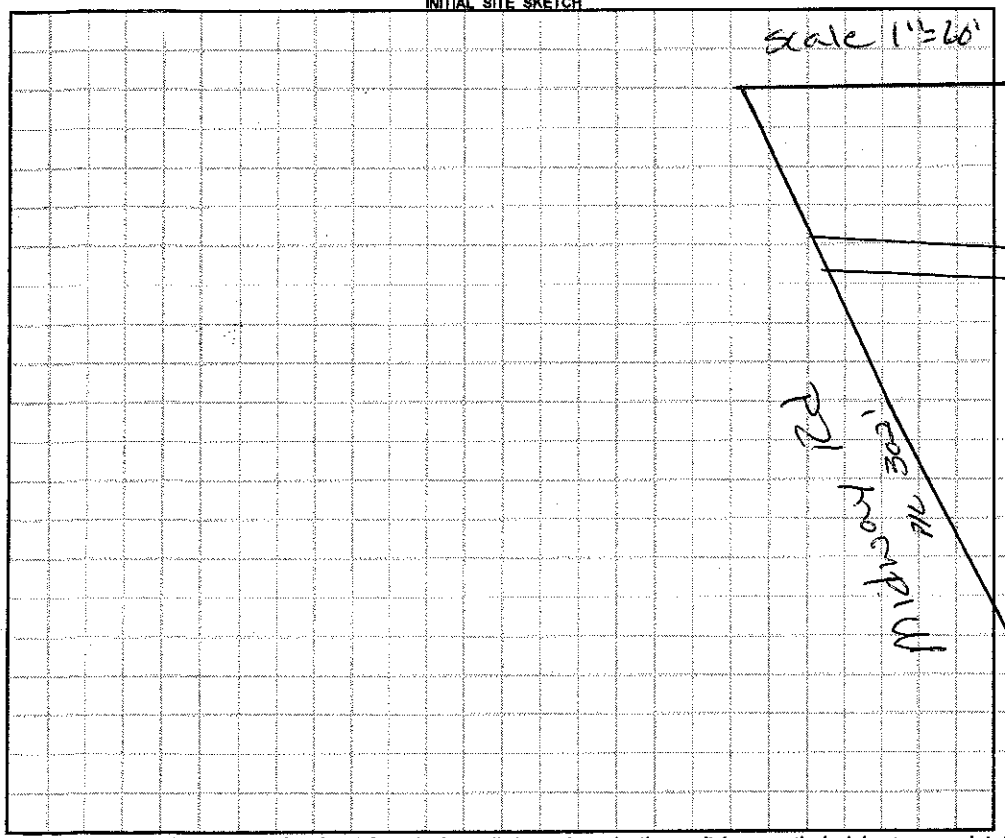

AS BUILT SKETCH

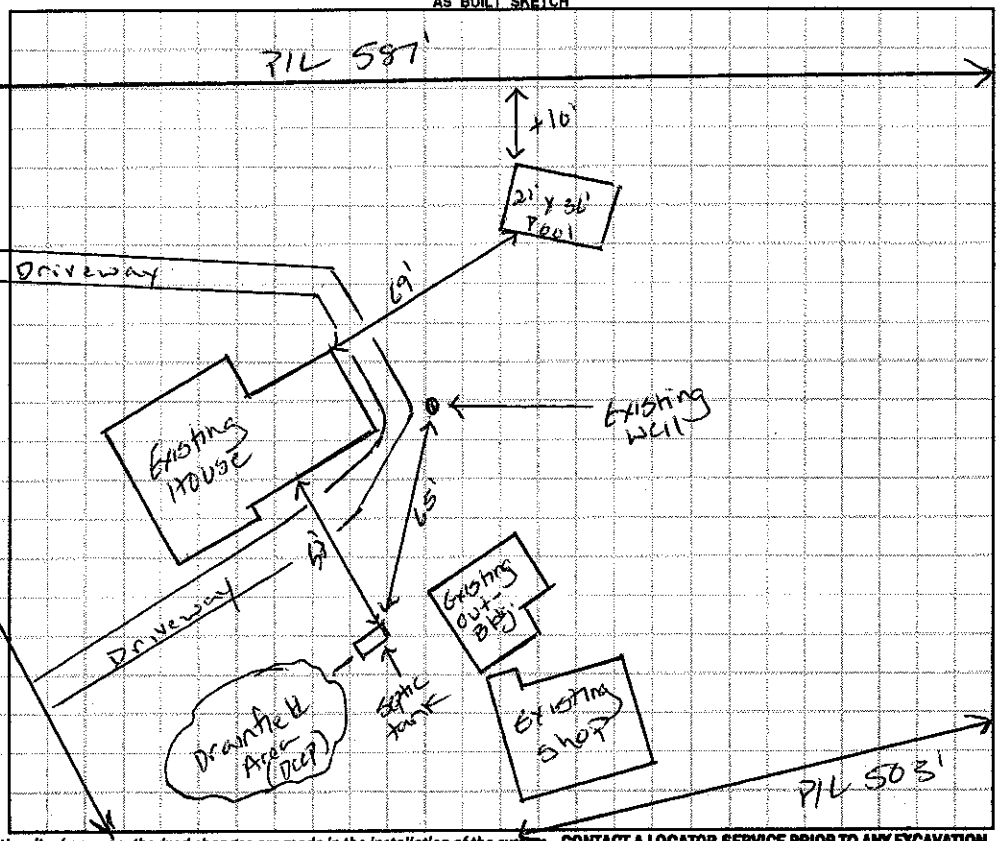

Permit can be suspended or revoked if any false information is supplied toward securing the permit / any unauthorized changes are made to the site / any unauthorized changes are made in the installation of the system. **CONTACT A LOCATOR SERVICE PRIOR TO ANY EXCAVATION**

☐ **IMPROVEMENT PERMIT** *with plat valid without expiration.* ☐ **IMPROVEMENT PERMIT** *with site plan valid for 60 mos.* ☐ **AUTHORIZATION TO CONSTRUCT** *valid for period equal to IMPROVEMENT PERMIT--not to exceed 60 mo.*

Owner / Applicant Signature: Lisa W Johnson — Date: 8/19/15 — Installed by:

IMPROVEMENT PERMIT by: — Date: — OPERATION PERMIT by: — Date:

AUTHORIZATION TO CONSTRUCT by: — Date: — Existing System Inspected by: Justin Henderson — Date: 8-19-15

Health Dept. Copy - WHITE Applicant (Final Approval) - YELLOW Applicant (Conditional Approval) - PINK