IREDELL COUNTY HEALTH DEPARTMENT

STATESVILLE 704-878-5305 (@) MOORESVILLE 704-664-5281

IMPROVEMENT PERMIT / AUTHORIZATION TO CONSTRUCT / OPERATION PERMIT / EXISTING SYSTEM INSPECTION

PERMIT # 15231 PIN # 4717-83-9052 DATE 29 October 08

OWNER or APPLICANT Bright Light Baptist Church PHONE: Business (704) 876-0994 Home:

OWNER or APPLICANT ADDRESS 428 Trinity Rd. Statesville, N.C.

LOCATION / DIRECTIONS Hwy 115 N TL Midway Rd. on Rt. Corner of Midway and Trinity Rd.

SUBDIVISION BLOCK / SECTION LOT # LOT AREA 5.54ac. DESIGN FLOW 897 g/d L.T.A.R. 0.39/FT²/d

Septic Tank 1500 Gallons: STB 338 Date 3-10-11
Pump Tank Gallons: P T Date
Pump Make Model Serial #
Nitrification Field No Fields 1 No Lines 6 Linear Feet 748
Trench Width 36" Max. Trench Bottom Depth 36" Gravel Depth NA

☑ New System ☐ Repair ☐ Expansion System Type I II (III) IV V VI
System Description: 25% Reduction
Repair System Description: 25% Reduction
Maintenance Agreement Required ☐ YES ☑ NO
☑ GRAVITY ☐ PRESSURE

☐ Residence No. Bedrooms
☐ Business No. Persons 299
☑ Other No. Employees
☐ Slab ☐ Crawl Space
☑ Basement w/plumbing ☐ Basement w/o plumbing

Water Supply
☑ Private
☐ Public
☐ Community

Comments / Conditions
* Follow contour / Homer setbacks

Comments / Conditions
ST has Risers
Polyhole filter

INITIAL SITE SKETCH

Please see attached Site sketch.

AS BUILT SKETCH

B10A36
Installed as drawn.

Permit can be suspended or revoked if any false information is supplied toward securing the permit / any unauthorized changes are made to the site / any unauthorized changes are made in the installation of the system.

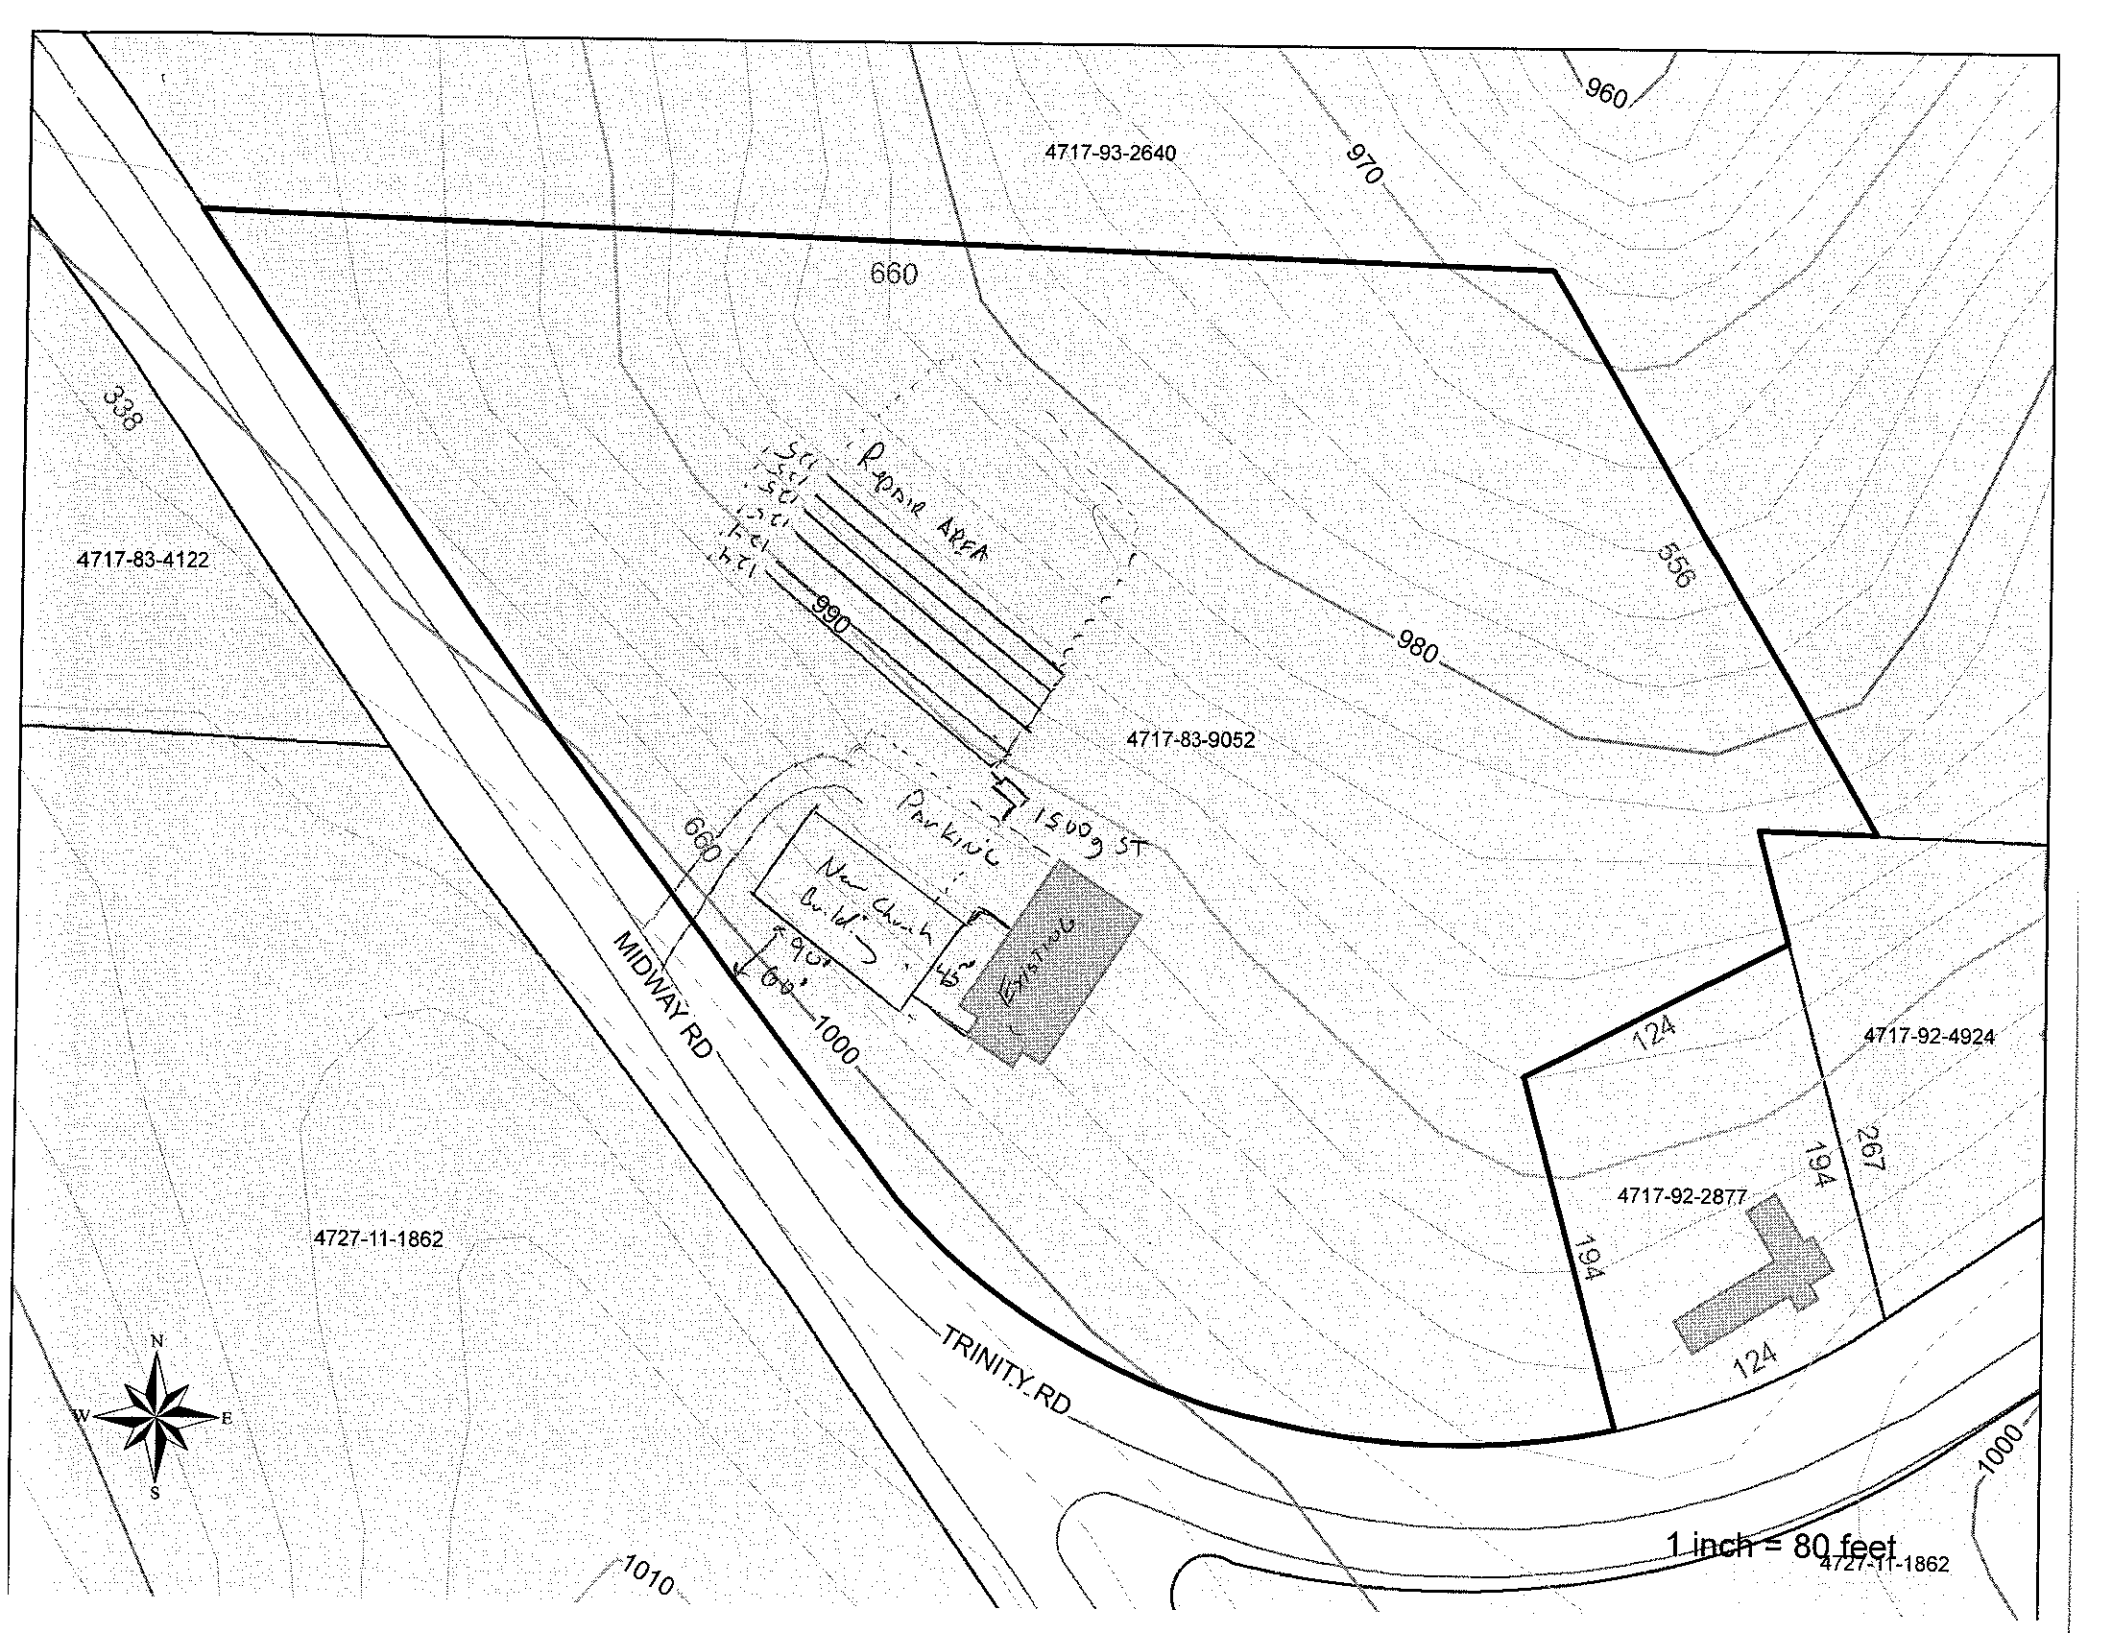
☐ *IMPROVEMENT PERMIT w / plat valid without expiration.* ☑ *IMPROVEMENT PERMIT w / site plan valid for 60 mos.* ☑ *AUTHORIZATION TO CONSTRUCT valid for period equal to IMPROVEMENT PERMIT-not to exceed 60 mo.*

Owner / Applicant Signature: Ted G Bowman Date 10/30/08
Improvement Permit by: R.S Date 30 Oct 08
Authorization to Construct by: R.S. Date 30 Oct 08

YOU SHOULD CONTACT A LOCATOR SERVICE PRIOR TO ANY EXCAVATION.

Installed by: James Huddleston
Operation Permit by: R.S Date: 30 Nov 11
Existing System Inspected by: Date:

WHITE COPY Environmental Health YELLOW COPY (Final) Owner / Applicant PINK COPY (Initial) Owner / Applicant


4717-93-2640
960
970
660
338
4717-83-4122
556
980
990
4717-83-9052
660
MIDWAY RD
1000
4717-92-4924
124
267
194
4717-92-2877
194
124
TRINITY RD
1000
4727-11-1862
1010
4727-11-1862
1 inch = 80 feet
N
W
E
S