IREDELL COUNTY HEALTH DEPARTMENT

STATESVILLE 704-878-5305 MOORESVILLE 704-664-5281

9:30

IMPROVEMENT PERMIT / AUTHORIZATION TO CONSTRUCT / OPERATION PERMIT / EXISTING SYSTEM INSPECTION

PERMIT# 92177 PIN# 4717 87 2018 DATE 10/4/00

OWNER OR CONTRACTOR NINA MARTIN PHONE: Business _____ Home 873-2547

ADDRESS 198 BIRCH WOOD DR. STATESVILLE NC 28625

LOCATION HWY 115 - TL MIONAY - TR COVE GAP - ON RT - # 224

SUBDIVISION — BLOCK / SECTION — LOT — LOT AREA 6.94AC SITE CLASS RS DESIGN FLOW 360GPD L.T.A.R. .3600/RT2

Septic Tank: 1000 Gallons; STB 1012 Date 6/22/00
Pump Tank: _____ Gallons; PT _____ Date _____
Pump Make: _____ Model _____ Serial No. _____
Nitrification Field: No Fields 1 Square Feet 1200 Linear Feet 400
No Lines 4@100' Trench Width 36" Max Trench Bottom Depth 36" Gravel Depth 12"

☑ New System ☐ Repair System Type: I (II) III. IV. V. VI
System Description: GRAVITY CONVENTIONAL
Repair System Description: SAME
Maintenance Agreement Required: ☐ Yes ☑ No


☑ House/Mod. Home No. Bedrooms 3
☐ Mobile Home No. Bathrooms 2
☐ Business No. Employees _____
☐ Other _____
☐ Slab ☑ Crawl Space ☐ Basement w/plumbing ☐ Basement wo/plumbing

Water Supply: ☑ Individual ☐ Public ☐ Community


Comments/Conditions:

Comments/Conditions:

1" = 60' INITIAL SITE SKETCH

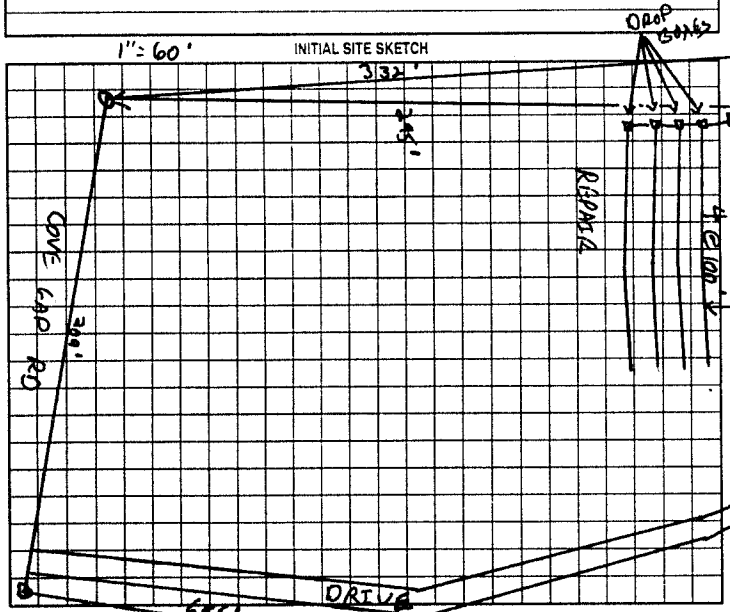

AS BUILT SKETCH

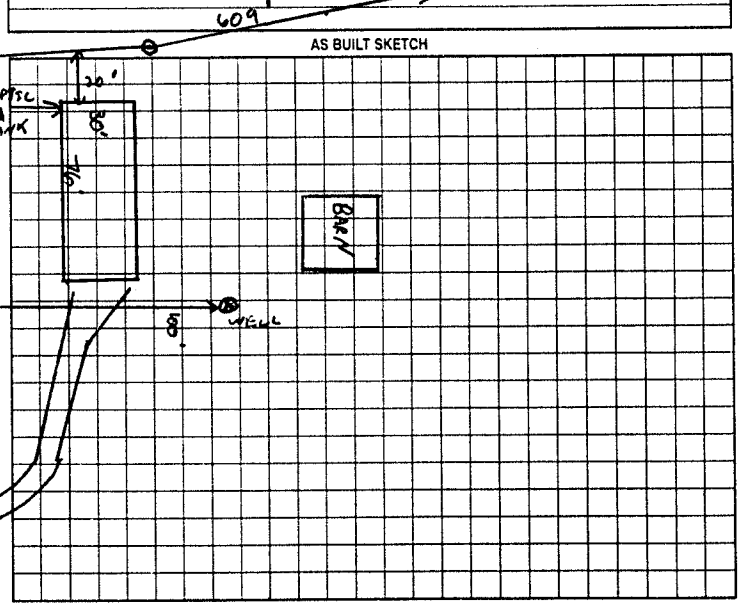

Permit can be suspended or revoked if any false information is supplied toward securing the permit/any unauthorized changes are made to the site/any unauthorized changes are made in the installation of the system. Improvement Permit with plat valid without expiration. Improvement Permit with site plan valid for sixty months. Authorization to Construct is valid for a period equal to that of Improvement Permit – not to exceed sixty months.

Signed: K Stadler date 10-9-00 Installed by: A-1 BACKHOE

Improvement Permit by: C. Bly RS date 10/4/00 Operation Permit by: C Bly RS date 10/16/00

Authorization to Construct by: C. Bly RS date 10/4/00 Existing System Inspection by: _____ date _____

HEALTH DEPT. COPY WHITE OWNER COPY (FINAL) YELLOW OWNER COPY (INITIAL) PINK