IREDELL COUNTY HEALTH DEPARTMENT

STATESVILLE 704-878-5305 (C1) MOORESVILLE 704-664-5281

IMPROVEMENT PERMIT / AUTHORIZATION TO CONSTRUCT / OPERATION PERMIT / EXISTING SYSTEM INSPECTION

PERMIT# 132602 PIN# 4717 90 3062 DATE 1/11/06

OWNER OR APPLICANT NELSON OELLINGER PHONE: Business 704 902 0429 Home

ADDRESS 304 BOWLES FARM RD STATESVILLE NC 28625

LOCATION 115 N (L) on HWY (R) HALLMARK (L) LOT 169 HALLMARK

SUBDIVISION NA BLOCK / SECTION LOT LOT AREA 9.77 ACRES SITE CLASS. PS DESIGN FLOW 360 gpd L.T.A.R. .3

Septic Tank: 1000 Gallons; STB 1012 Date 7-26-05
Pump Tank: Gallons; PT Date
Pump Make: Model Serial No.
Nitrification Field: No Fields 1 Square Feet 1200 Linear Feet 300
No Lines 2 Trench Width 36" Max Trench Bottom Depth 36" Gravel Depth NA

☒ New System ☐ Repair ☐ Expansion System Type: I (II) III IV V VI
System Description: 25% REDUCTION
Repair System Description: CONVENTIONAL
Maintenance Agreement Required: ☐ Yes ☒ No

☒ House/Mod. Home No. Bedrooms 3
☐ Mobile Home No. Persons
☐ Business No. Employees
☐ Other


Water Supply: ☒ Individual ☐ Public ☐ Community

☒ Gravity ☐ Pressure ☐ Slab ☐ Crawl Space ☒ Basement w/plumbing ☐ Basement wo/plumbing


Comments/Conditions: install on contour. maintain setbacks.

Comments/Conditions: (2) SYSTEM ALTERED AS SHOWN BELOW (2) SEPTIC TANK WITH MARKER INSTALLED USING "TUFTITE" FILTER

INITIAL SITE SKETCH

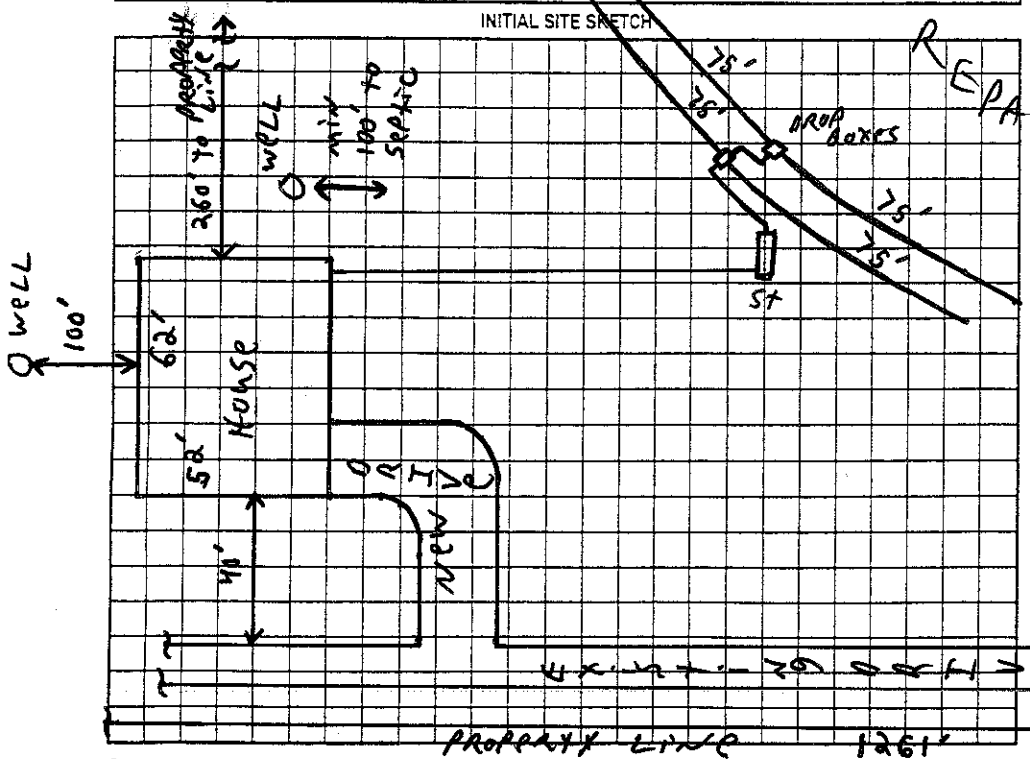

AS BUILT SKETCH

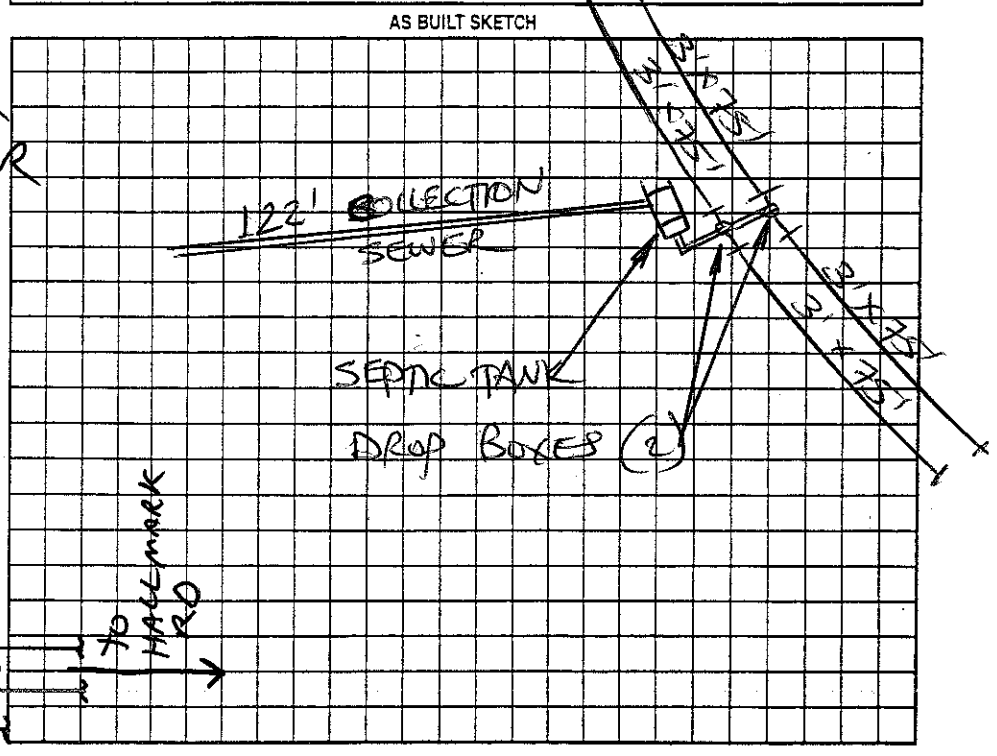

Permit can be suspended or revoked if any false information is supplied toward securing the permit/any unauthorized changes are made to the site/any unauthorized changes are made in the installation of the system. Improvement Permit with plat valid without expiration ☐ Improvement Permit with site plan valid for sixty months ☒ Authorization to Construct is valid for a period equal to that of Improvement Permit – not to exceed sixty months.

Signed: date 1-23-06 Installed by: CRAIG THOMPSON

Improvement Permit by: date 1/11/06 Operation Permit by: STEVE HEDRICK date 3-14-06

Authorization to Construct by: date 1/11/06 Existing System Inspection by: date

HEALTH DEPT. COPY: WHITE OWNER COPY (FINAL): YELLOW OWNER COPY (INITIAL): PINK