IREDELL COUNTY HEALTH DEPARTMENT

STATESVILLE 704-878-5305 MOORESVILLE 704-664-5281

IMPROVEMENT PERMIT / AUTHORIZATION TO CONSTRUCT / OPERATION PERMIT / EXISTING SYSTEM INSPECTION

DATE 31 October 06

PERMIT# 138469 PIN# 4719-93-9195 PHONE: Business 828-322-1294 Home

OWNER OR APPLICANT St. Joseph Baptist Church - Fellowship Hall Addn. Architect

ADDRESS 260 Four Acre Rd. NW Clay Build. Sys. 200 Hwy 70 E. Statesville, N.C. 28625

LOCATION 413 Inv. #1 Rt. Statesville, N.C. 28625 SUBDIVISION BLOCK / SECTION LOT LOT AREA 3.865 SITE CLASS. PS DESIGN FLOW 750 gpd L.T.A.R. 0.37 gpd/sf

Septic Tank: 1500 Gallons; STB 19D Date 7-23-13

Pump Tank: Gallons; PT Date

Pump Make: Model Serial No.

Nitrification Field: No Fields 1 Square Feet 1900 Linear Feet 475

No Lines 4 Trench Width 36" Max Trench Bottom Depth 36"

☐ New System ☐ Repair ☑ Expansion System Type: I (II) III IV V VI

System Description: 25% Reduction - Accepted

Repair System Description: Pressure 25% Reduction - Accepted

Maintenance Agreement Required: ☐ Yes ☑ No

Gravel Depth N/A ☑ Gravity ☐ Pressure

☐ House/Mod. Home ☐ Mobile Home ☐ Business ☑ Other Church Fellowship Hall

No. Bedrooms No. Persons 150 No. Employees


Water Supply: ☑ Individual ☐ Public ☐ Community

☑ Slab ☑ Crawl Space ☐ Basement w/plumbing ☐ Basement wo/plumbing

Comments:/Conditions: Church has an exist. ST and Approx. 600 Ft. in use now without any evidence of Failure. Add 1500 g ST and 1900 Ft.² of Infiltrator System / Keep up slope as far as poss. b/c / Follow contour / use 4 Drop-Boxes

Comments:/Conditions:

INITIAL SITE SKETCH

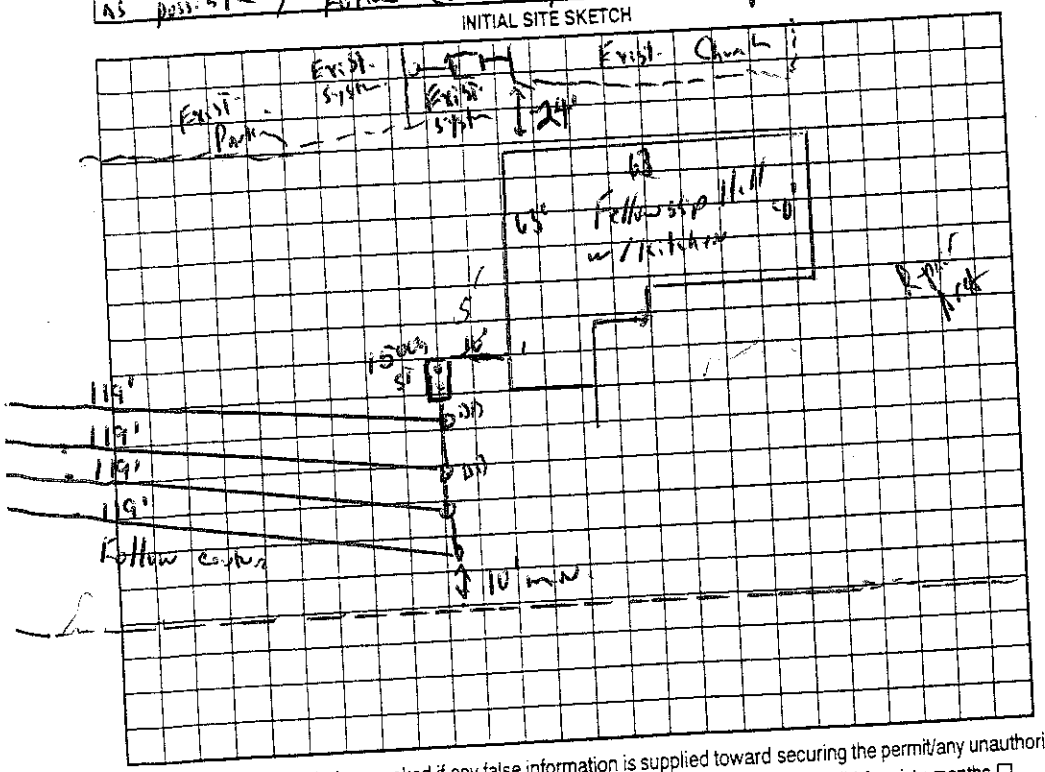

AS BUILT SKETCH

Permit can be suspended or revoked if any false information is supplied toward securing the permit/any unauthorized changes are made to the site/any unauthorized changes are made in the installation of the system. Improvement Authorization to Construct is valid for a period equal to that of Improvement Permit – not to exceed sixty months.

Permit with plat valid without expiration ☐ Improvement Permit with site plan valid for sixty months ☐

Signed: date 10/31/06

Improvement Permit by: R.S. date 31 Oct. 06

Authorization to Construct by: R.S. date 31 Oct. 06

Installed by: Kevin Bowles date 9-24-13

Operation Permit by: date

Existing System Inspection by:

HEALTH DEPT. COPY: WHITE OWNER COPY (FINAL): YELLOW OWNER COPY (INITIAL): PINK