IREDELL COUNTY HEALTH DEPARTMENT

11E-A-84 on terminal

STATESVILLE 704-878-5305 MOORESVILLE 704-664-5281

21082

IMPROVEMENT PERMIT / CERTIFICATE OF COMPLETION / OPERATION PERMIT / EXISTING SYSTEM INSPECTION

PROPERTY DESCRIPTION NO. 21082 DATE 6/13/95 TAX MAP NO. 14E-A-84 Watershed: ☐ Yes ☑ No

OWNER OR CONTRACTOR KENT W. MOORE PHONE: Business 872-9511 Home 876-6279

ADDRESS RT. 2, BOX 204R, HIDDENITE, NC 28636

LOCATION NC 115 N, TL PISGAH CH. ROAD, ~0.5 MI ON LEFT PAST BOWLES FARM ROAD

SUBDIVISION BLOCK / SECTION LOT LOT AREA 17.78 AC SITE CLASS PS DESIGN FLOW 360 L.T.A.R. 0.35 GPD/FT

Septic Tank: 1000 Gallons: STB 1012 Date 5/17/96
Pump Tank: Gallons: PT Date
Pump Make: Model Serial No.
Nitrification Field: No Fields 1 Square Feet 1035 Linear Feet 345
No Lines 3 Trench Width 36" Max Trench Bottom Depth 18-36" Gravel Depth 12"

☑ New System ☐ Repair System Type: I, II, III, IV, V, VI
System Description: CONV. GRAVITY
Repair System Description: CONV. GRAVITY
Maintenance Agreement Required: ☐ Yes ☑ No
☐ Slab ☑ Crawl Space ☐ Basement w/plumbing ☐ Basement w/o plumbing


☑ House/Mod. Home No. Bedrooms 3
☐ Mobile Home No. Bathrooms 2½
☐ Business No. Employees
☐ Other

Water Supply:
☑ Individual
☐ Community
☐ Public
WELL


Comments: ① KEEP SYSTEM MINIMUM 5' FROM HOUSE 100' FROM WELL ② INSTALL LINES ON CONTOUR NO DEEPER THAN 36", 9' MIN APART ON CENTER

Comments:

INITIAL SITE SKETCH

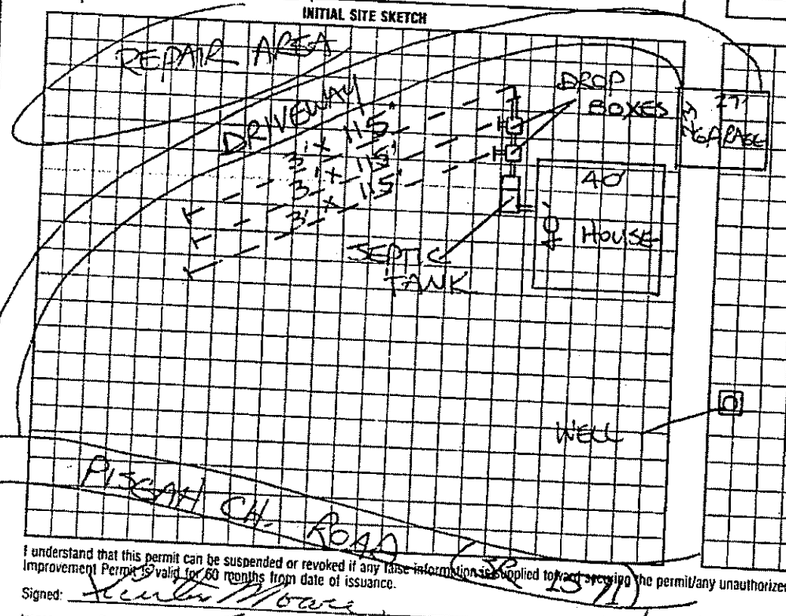

AS BUILT SKETCH

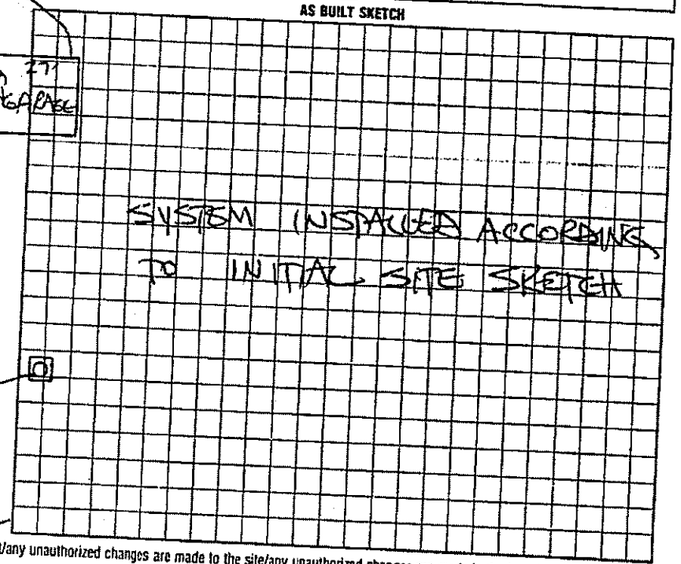

I understand that this permit can be suspended or revoked if any false information is supplied toward securing the permit/any unauthorized changes are made to the site/any unauthorized changes are made in the installation of the system. Improvement Permit is valid for 60 months from date of issuance.

Signed: Kent Moore

Improvement Permit by: STEVE HEDRICK date 6/13/95

Existing System Inspection by: date

Installed by: KENNY PEARSON

Certificate of Completion by: date

Operation Permit by: STEVE HEDRICK date 8-15-96

HEALTH DEPT COPY: WHITE INSPECTION COPY (FINAL) GREEN OWNER COPY (FINAL) YELLOW INSPECTION COPY (INITIAL) PINK OWNER COPY (INITIAL) GOLD