IREDELL COUNTY HEALTH DEPARTMENT

Statesville Phone TR 3-7271 Mooresville Phone NO 3-1271

PERMIT TO INSTALL SEPTIC TANK

Permit NO. _____ Permit Date June 18 1963

Owner Mr. Lon Lackey Address _____

Installed By Roy Ludt Address Statesville


Location of Property Four miles on Pisgah Church Rd.
On Right from Hwy 115 North

| Tank | | Capacity | | Length of Lines | | Fixtures | |
|---|---|---|---|---|---|---|---|
| Block | ( ) | 800 | ( ) | 150' | ( ) | No. of Baths | (1) |
| Precast | ( ) | 900 | ( ) | 175' | ( ) | Dishwasher | ( ) |
| Cond | | 1000 | (1) | 200' | ( ) | Garbage Grdr. | ( ) |
| | | 1100 | ( ) | 225' | (1) | Auto-Washer | (1) |
| | | 1200 | ( ) | 250' | ( ) | Other | _____ |
| | | Other | _____ | Other | _____ | | |

NOTIFY HEALTH DEPARTMENT AT LEAST EIGHT HOURS BEFORE TANK IS TO BE INSPECTED.

Final Inspection 6-18 1963 Approved (1) Disapproved ( )

Remarks Owner

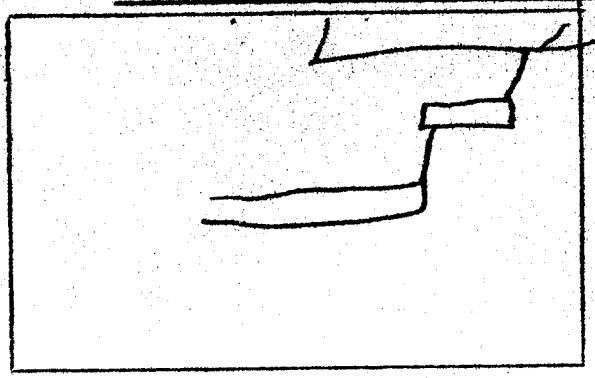


Sketch of Installation

Sanitarian