IREDELL COUNTY HEALTH DEPARTMENT

Statesville Office (704) 878-5305 Mooresville Office (704) 660-3625 PERMIT # 177098

IMPROVEMENT PERMIT / AUTHORIZATION TO CONSTRUCT / OPERATION PERMIT / EXISTING SYSTEM

PIN # 4718267217

APPLICANT: Trinity Steel Buildings APPLICANT ADDRESS: 2835 Chenault Rd.

SITE ADDRESS: 581 Pisgah Church Rd. PHONE: 704-278-4508 ALT. PHONE: N/A

SITE DIRECTIONS: Hwy 115N TL Pisgah Church Rd.


SUBDIVISION: N/A SECTION: N/A LOT # N/A LOT AREA: 1.88 acres DESIGN FLOW: 200 gpd L.T.A.R.: Existing

Septic Tank	Existing	(gal)	STB	Date	☐ New System ☐ Repair ☐ Expansion	System Type: I ☑ II III IV V VI	☐ Residence	No. Bedrooms	Water Supply
Pump Tank		(gal)	PT	Date	System Description:	Conventional	☐ Business	No. Persons 10	☑ Private
Pump Make		Model		Serial #	Repair System Description:		☑ Other Fire Depart.	No. Employees	☐ Public
# Nitrification Fields	1	# Lines	2	Linear Ft: 6x	Maintenance Agreement Required:	☐ YES ☑ NO	☐ Slab	☐ Crawl Space	☐ Community
Trench Width	6x	Max. Trench Bottom Depth	6x	Gravel Depth 12"	☑ GRAVITY	☐ PRESSURE	☐ Basement w/plumbing		☐ Basement w/o plumbing


Comments / Conditions:

Maintain a minimum of 5' between addition foundation and all components of septic tank system.

INITIAL SITE SKETCH

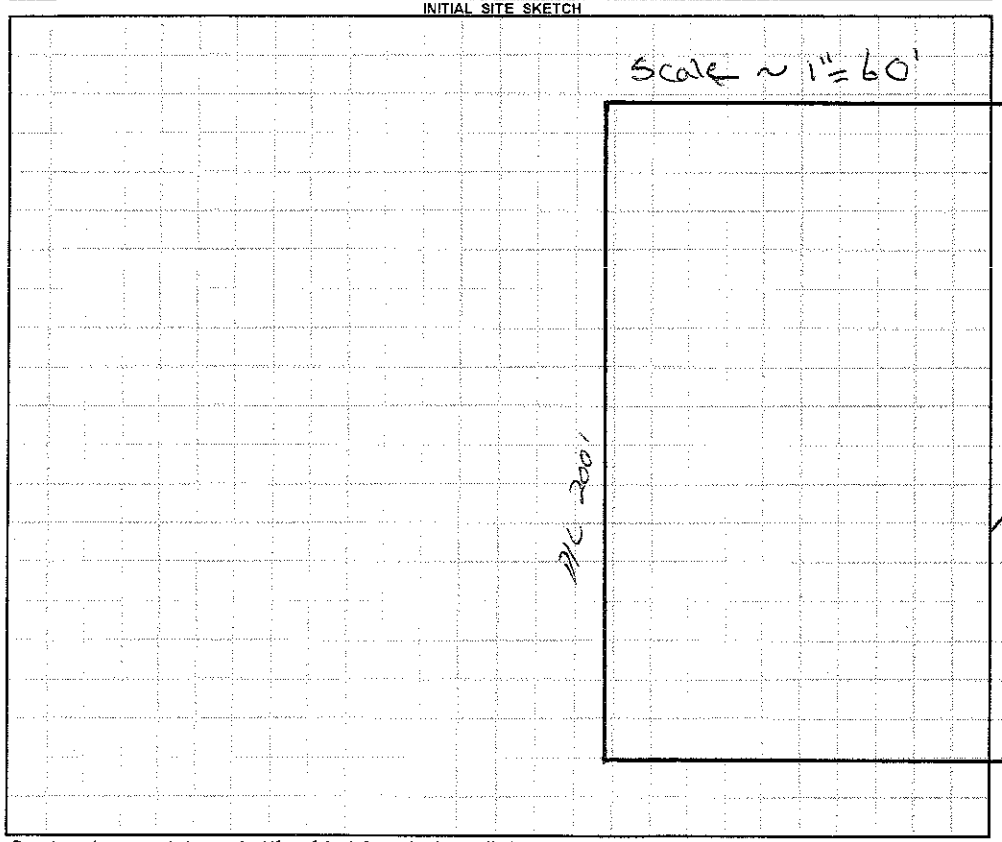

AS BUILT SKETCH

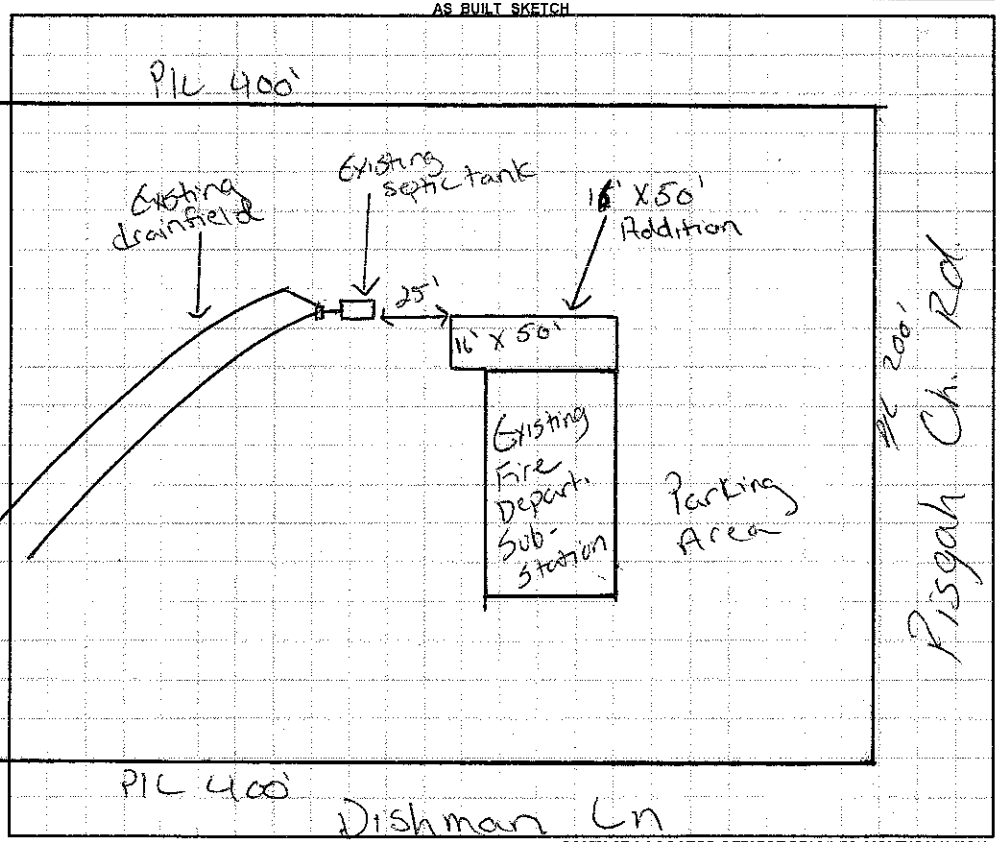

Permit can be suspended or revoked if any false information is supplied toward securing the permit / any unauthorized changes are made to the site / any unauthorized changes are made in the installation of the system. **CONTACT A LOCATOR SERVICE PRIOR TO ANY EXCAVATION**

☐ **IMPROVEMENT PERMIT** ***with plat*** *valid without expiration.* ☐ **IMPROVEMENT PERMIT** ***with site plan*** *valid for 60 mos.* ☐ **AUTHORIZATION TO CONSTRUCT** *valid for period equal to IMPROVEMENT PERMIT--not to exceed 60 mo.*

Owner / Applicant Signature: _____ Date: _____ Installed by: _____

IMPROVEMENT PERMIT by: _____ Date: _____ OPERATION PERMIT by: _____ Date: _____

AUTHORIZATION TO CONSTRUCT by: _____ Date: _____ Existing System Inspected by: Justin Henderson Date: 2-15-13

Health Dept. Copy - WHITE Applicant (Final Approval) - YELLOW Applicant (Conditional Approval) - PINK