IREDELL COUNTY HEALTH DEPARTMENT

STATESVILLE 704-878-5305 MOORESVILLE 704-664-5281

IMPROVEMENT PERMIT / AUTHORIZATION TO CONSTRUCT / OPERATION PERMIT / EXISTING SYSTEM INSPECTION

PERMIT# 82122 PIN# 4718 26 9241 DATE 7-2-99

OWNER OR CONTRACTOR Joel Douglas PHONE: Business Home 585 2330

ADDRESS 475 Antietam Rd

LOCATION 115W TL Pisgah ch on left at Dishman Rd

SUBDIVISION Douglas mtp BLOCK / SECTION LOT LOT AREA 1 Acre SITE CLASS. PS DESIGN FLOW 240 L.T.A.R. .13

Septic Tank: 1000 Gallons; STB 1012 Date 5-14-99
Pump Tank: Gallons; PT Date
Pump Make: Model Serial No.
Nitrification Field: No Fields 1 Square Feet 810 Linear Feet 270
No Lines 3 Trench Width 36" Max Trench Bottom Depth 36" Gravel Depth 12"

☐ New System ☐ Repair System Type: I ☒ II ☐ III ☐ IV ☐ V ☐ VI
System Description: Conv. Gravity
Repair System Description: Pump To 25% Rdtn
Maintenance Agreement Required: ☐ Yes ☒ No

☐ House/Mod. Home ☐ Mobile Home ☐ Business ☐ Other
No. Bedrooms 2 No. Bathrooms 2 No. Employees


☐ Slab ☒ Crawl Space ☐ Basement w/plumbing ☐ Basement wo/plumbing

Water Supply: ☐ Individual ☐ Public ☐ Community


Comments/Conditions:

Comments/Conditions

INITIAL SITE SKETCH

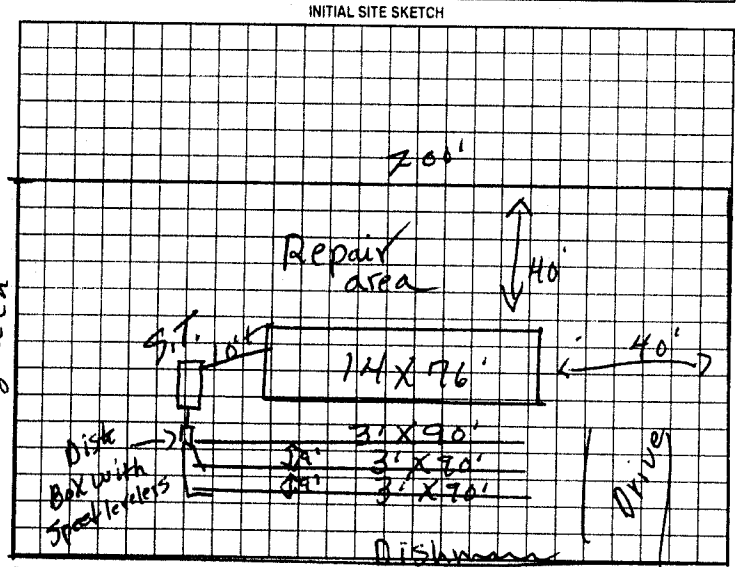

AS BUILT SKETCH

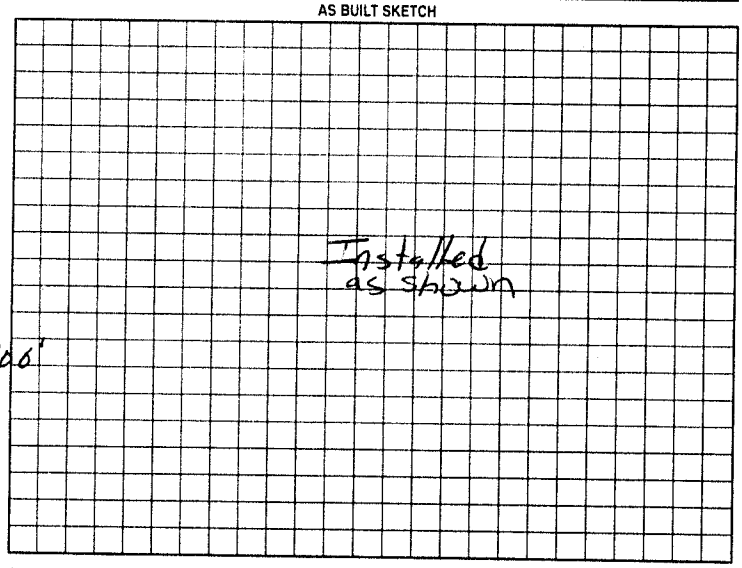

Permit can be suspended or revoked if any false information is supplied toward securing the permit/any unauthorized changes are made to the site/any unauthorized changes are made in the installation of the system. Improvement Permit with plat valid without expiration. Improvement Permit with site plan valid for sixty months. Authorization to Construct is valid for a period equal to that of Improvement Permit – not to exceed sixty months.

Signed: X Joel Douglas date

Improvement Permit by: P.C. Moore date 7-2-99

Authorization to Construct by: P.C. Moore date 7-2-99

Installed by: A-1 Backhoe

Operation Permit by: Mary Coffers date 7-15-99

Existing System Inspection by: date

HEALTH DEPT COPY WHITE OWNER COPY (FINAL) YELLOW OWNER COPY (INITIAL) PINK