IREDELL COUNTY HEALTH DEPARTMENT

STATESVILLE 704-878-5305 CI MOORESVILLE 704-664-5281

IMPROVEMENT PERMIT / AUTHORIZATION TO CONSTRUCT / OPERATION PERMIT / EXISTING SYSTEM INSPECTION

PERMIT# 11277 L PIN# 4718-28-2995 4718-27-0496 DATE 5-20-03

OWNER OR CONTRACTOR BENNY N. JOHNSON PHONE: Business 704-881-5217 Home 704-585-2755

ADDRESS 1540 MIDWAY ROAD, STONY POINT NC 28678

LOCATION NC 115 NORTH, TL PISGAH CHURCH ROAD, TR BOWLES FARM ROAD, LOT ON RIGHT ON CORNER

SUBDIVISION _____ BLOCK / SECTION _____ LOT _____ LOT AREA 2.433 ACRES SITE CLASS. PS DESIGN FLOW 360 L.T.A.R. 0.30 gpd/ft²

Septic Tank: 1000 Gallons; STB 1007 Date 5-12-03
Pump Tank: _____ Gallons; PT _____ Date _____
Pump Make: _____ Model _____ Serial No. _____
Nitrification Field: No Fields 1 Square Feet 1200 Linear Feet 400
No Lines FIVE Trench Width 36" Max Trench Bottom Depth 24" Gravel Depth 12"

☑ New System ☐ Repair System Type: I (II) III. IV. V. VI
System Description: CONVENTIONAL GRAVITY
Repair System Description: 25% REDUCTION, GRAVITY
Maintenance Agreement Required: ☐ Yes ☑ No
☐ Slab ☑ Crawl Space ☐ Basement w/plumbing ☐ Basement wo/plumbing


☑ House/Mod. Home No. Bedrooms 3
☐ Mobile Home No. Bathrooms 2
☐ Business No. Employees ____
☐ Other _____

Water Supply: ☑ Individual ☐ Public ☐ Community WELL


Comments/Conditions: ① KEEP SYSTEM MINIMUM 100 FEET FROM WELL ② INSTALL SUBSURFACE INTERCEPT DRAINAGE DITCH AS SHOWN BEGINNING 40" DEEP, OUT TO DAYLIGHT ③ INSTALL LINES ON CONTOUR, NO DEEPER THAN 24"

Comments/Conditions: - Poly Lok filter + ST Marker Installed

INITIAL SITE SKETCH SCALE: 1" = 40'

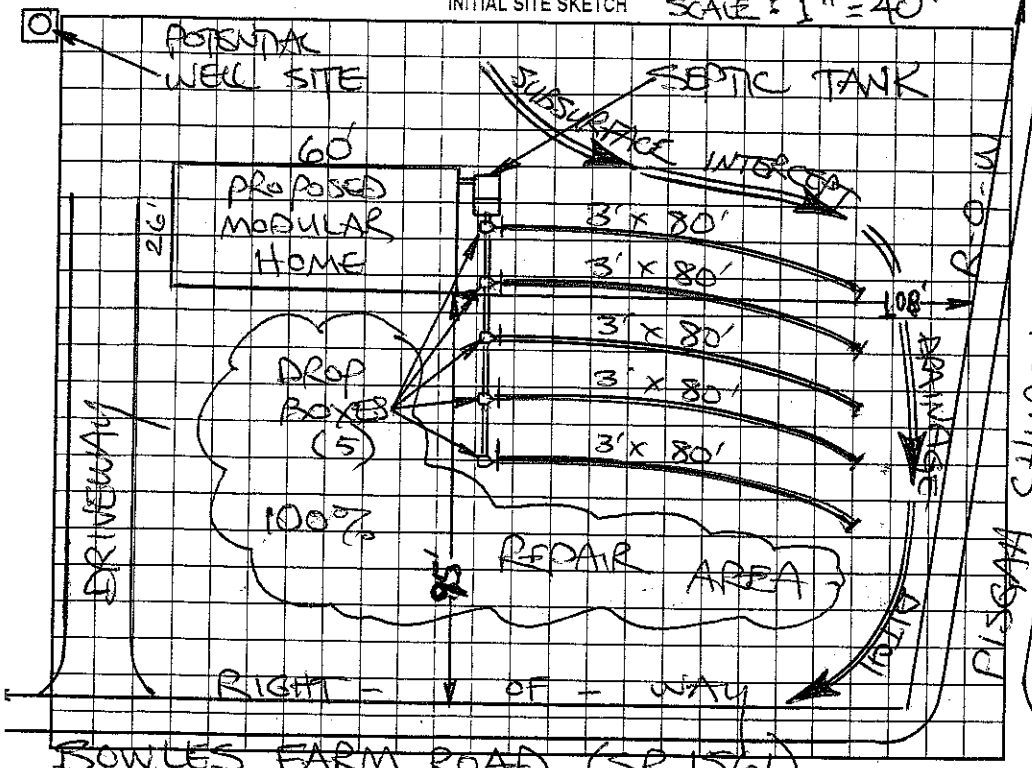

AS BUILT SKETCH

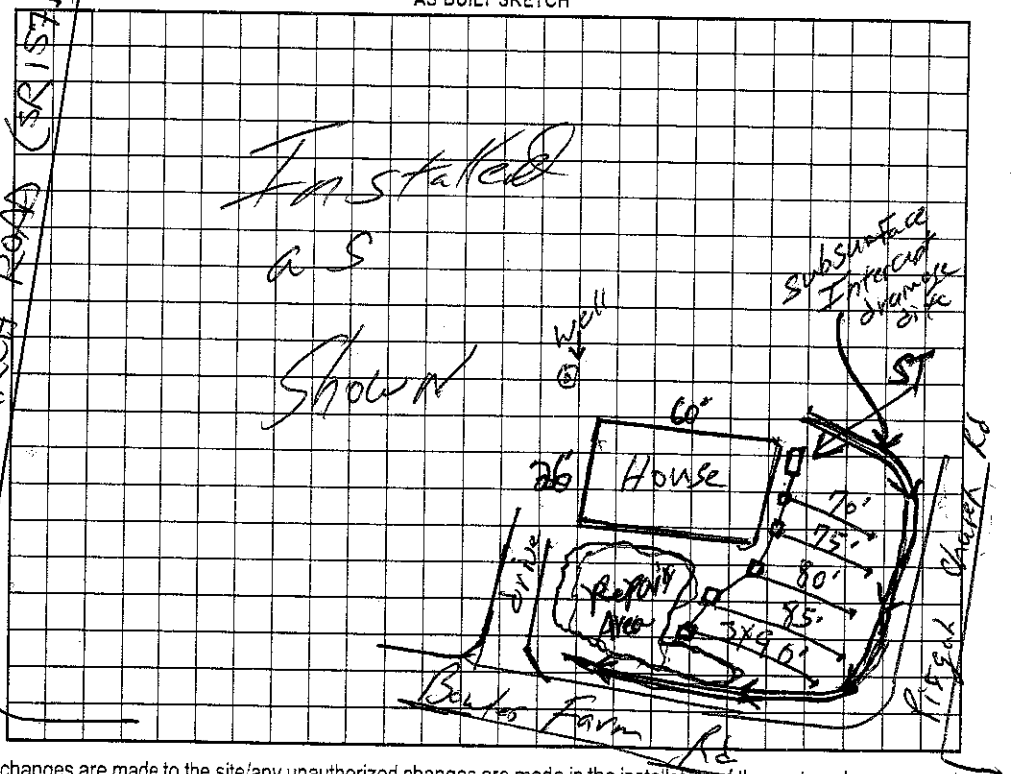

Permit can be suspended or revoked if any false information is supplied toward securing the permit/any unauthorized changes are made to the site/any unauthorized changes are made in the installation of the system. Improvement Permit with plat valid without expiration. Improvement Permit with site plan valid for sixty months. Authorization to Construct is valid for a period equal to that of Improvement Permit – not to exceed sixty months.

Signed: Benny Johnson date 5-20-03 Installed by: Tommy Cothran Son

Improvement Permit by: STEVE HEDRICK date 5-20-03 Operation Permit by: William C. Johnson date 7/8/03

Authorization to Construct by: STEVE HEDRICK date 5-20-03 Existing System Inspection by: _____ date _____

HEALTH DEPT. COPY: WHITE OWNER COPY (FINAL): YELLOW OWNER COPY (INITIAL): PINK