THIS PERMIT VOIDS PREVIOUS ISSUED 6-10-2000

IREDELL COUNTY HEALTH DEPARTMENT

STATESVILLE 704-878-5305 MOORESVILLE 704-664-5281

IMPROVEMENT PERMIT / AUTHORIZATION TO CONSTRUCT / OPERATION PERMIT / EXISTING SYSTEM INSPECTION

PERMIT# 089554 PIN# 4718 35 0897 (PT) DATE 9-15-00

OWNER OR CONTRACTOR RICKY L. MILLSAPS, SR PHONE: Business Home 592-2070

ADDRESS 764 MTN. VIEW ROAD, STATESVILLE, NC 28625

LOCATION NC 115 N, TL PISGAH CH. ROAD, LOT ON LEFT 2ND BEFORE DISHMAN LANE

SUBDIVISION RICKY MILLSAPS BLOCK / SECTION LOT 1 LOT AREA ~0.63 ACRE SITE CLASS PS DESIGN FLOW 360 L.T.A.R. 0.30 GPD/FT2

Septic Tank: 1000 Gallons; STB 794 Date 4-30-00
Pump Tank: Gallons; PT Date
Pump Make: Model Serial No.
Nitrification Field: No Fields 1 Square Feet 1200 Linear Feet 400
No Lines Four Trench Width 36" Max Trench Bottom Depth 36" Gravel Depth 12"

☑ New System ☐ Repair System Type: I (II) III IV V VI
System Description: CONVENTIONAL GRAVITY
Repair System Description: 50% REDUCTION GRAVITY
Maintenance Agreement Required: ☐ Yes ☑ No


☐ House/Mod. Home No. Bedrooms 3
☑ Mobile Home No. Bathrooms 2
☐ Business No. Employees
☐ Other
☐ Slab ☑ Crawl Space ☐ Basement w/plumbing ☐ Basement wo/plumbing

Water Supply: ☑ Individual ☐ Public ☐ Community WELL

Comments/Conditions: NO WELLS TO BE LOCATED WITHIN 100 FEET OF SEPTIC SYSTEM

Comments/Conditions ① SYSTEM INSTALLED DURING WET SOIL CONDITIONS ② SEPTIC TANK WITH MARKER INSTALLED USING "ZABEL" FILTER

INITIAL SITE SKETCH

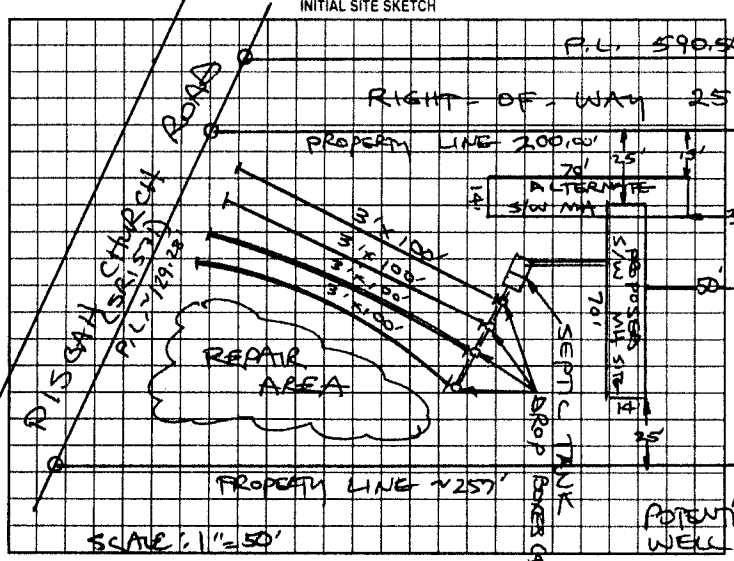

AS BUILT SKETCH

AS SHOWN

Permit can be suspended or revoked if any false information is supplied toward securing the permit/any unauthorized changes are made to the site/any unauthorized changes are made in the installation of the system. Improvement Permit with plat valid without expiration. Improvement Permit with site plan valid for sixty months. Authorization to Construct is valid for a period equal to that of Improvement Permit -- not to exceed sixty months.

Signed: Ricky Millsaps date 9-19-00 Installed by: BARRY SIGMON

Improvement Permit by: STEVE HENDRICK date 9-15-00 Operation Permit by: STEVE HENDRICK date 9-26-00

Authorization to Construct by: STEVE HENDRICK date 9-15-00 Existing System Inspection by: date

HEALTH DEPT COPY WHITE OWNER COPY (FINAL) YELLOW OWNER COPY (INITIAL) PINK