10:30

IREDELL COUNTY HEALTH DEPARTMENT

Statesville Office (704) 878-5305 Mooresville Office (704) 660-3625 PERMIT # 176999

IMPROVEMENT PERMIT / AUTHORIZATION TO CONSTRUCT / OPERATION PERMIT / EXISTING SYSTEM

PIN # 4718365624

APPLICANT: Hal Lackey APPLICANT ADDRESS: 584 Pisgah Church Rd.

SITE ADDRESS: 584 Pisgah Church Rd. PHONE: 704-380-2798 ALT. PHONE: N/A

SITE DIRECTIONS: Hwy 115 N TL Pisgah Church Rd.

SUBDIVISION: N/A SECTION: N/A LOT # N/A LOT AREA: 10.8 acres DESIGN FLOW: 360 gpd L.T.A.R.: 0.3

Septic Tank Existing (gal) STB Date
Pump Tank (gal) PT Date
Pump Make Model Serial #
Nitrification Fields 1 # Lines 2 Linear Ft: 160
Trench Width 36" Max. Trench Bottom Depth 36" Gravel Depth N/A


☐ New System ☑ Repair ☐ Expansion System Type: I II III IV V VI
System Description:
Repair System Description: 25% Reduction + Existing
Maintenance Agreement Required: ☐ YES ☑ NO
☑ GRAVITY ☐ PRESSURE

☑ Residence No. Bedrooms 3
☐ Business No. Persons
☐ Other No. Employees
☐ Slab ☑ Crawl Space
☐ Basement w/plumbing ☐ Basement w/o plumbing

Water Supply: ☑ Private ☐ Public ☐ Community

Comments / Conditions: Install a 25% Reduction System on contour with serial distribution. Set D-boxes on existing lines as shown below. Replace septic tank if needed. Grade to uniform slope over drainfield area to shed water.

INITIAL SITE SKETCH

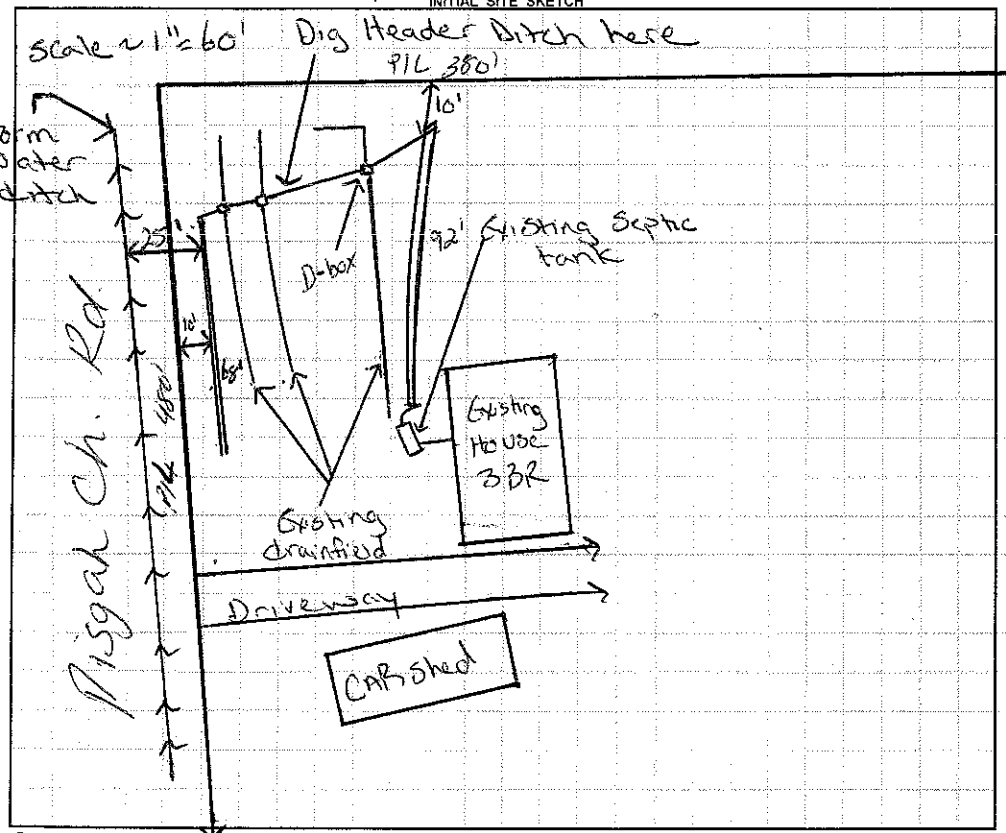

AS BUILT SKETCH

Arc 36"

Permit can be suspended or revoked if any false information is supplied toward securing the permit / any unauthorized changes are made to the site / any unauthorized changes are made in the installation of the system. **CONTACT A LOCATOR SERVICE PRIOR TO ANY EXCAVATION**

☐ **IMPROVEMENT PERMIT** *with plat valid without expiration.* ☑ **IMPROVEMENT PERMIT** *with site plan valid for 60 mos.* ☒ **AUTHORIZATION TO CONSTRUCT** *valid for period equal to IMPROVEMENT PERMIT--not to exceed 60 mo.*

Owner / Applicant Signature: Date: 2/19/13 Installed by: Kelly Welborn Grading

IMPROVEMENT PERMIT by: Date: 2-15-13 OPERATION PERMIT by: Date: 3-8-13

AUTHORIZATION TO CONSTRUCT by: Date: 2-15-13 Existing System Inspected by: Date:

Health Dept. Copy - WHITE Applicant (Final Approval) - YELLOW Applicant (Conditional Approval) - PINK