Susan Aldridge

IREDELL COUNTY HEALTH DEPARTMENT

STATESVILLE 704-878-5305 (a) MOORESVILLE 704-664-5281

RSH

IMPROVEMENT PERMIT / AUTHORIZATION TO CONSTRUCT / OPERATION PERMIT / EXISTING SYSTEM INSPECTION

PERMIT # 157979 PIN # 4718366385 DATE 9-8-09

OWNER or APPLICANT Built rite Construction PHONE: Business Home: 704-876-1955

OWNER or APPLICANT ADDRESS 245 Turbark Road Statesville NC 28625

LOCATION / DIRECTIONS 115N (R) Pisgah Rd just before 550 bus # on right

SUBDIVISION BLOCK / SECTION LOT # LOT AREA 10+ AC DESIGN FLOW 360 L.T.A.R. .25

Septic Tank 1500 Gallons: STB 160 Date 7-7-10

Pump Tank Gallons: P T Date

Pump Make Model Serial #

Nitrification Field No Fields 1 No Lines 4 Linear Feet 360

Trench Width 36" Max. Trench Bottom Depth 34" Gravel Depth N/A

☐ New System ☐ Repair ☐ Expansion System Type I (III) IV V VI

System Description: 25% Gravel

Repair System Description: 25% Gravel

Maintenance Agreement Required ☐ YES (☐) NO

☑ GRAVITY ☐ PRESSURE

☑ Residence No. Bedrooms 3

☐ Business No. Persons

☐ Other No. Employees

☐ Slab ☐ Crawl Space

☐ Basement w/plumbing ☐ Basement w/o plumbing

Water Supply: ☑ Private ☐ Public ☐ Community

Comments / Conditions


Unstall on contour
Maintain all setbacks

Comments / Conditions


(1) Must use (4) drop boxes

(2) 25' from house to line one

INITIAL SITE SKETCH

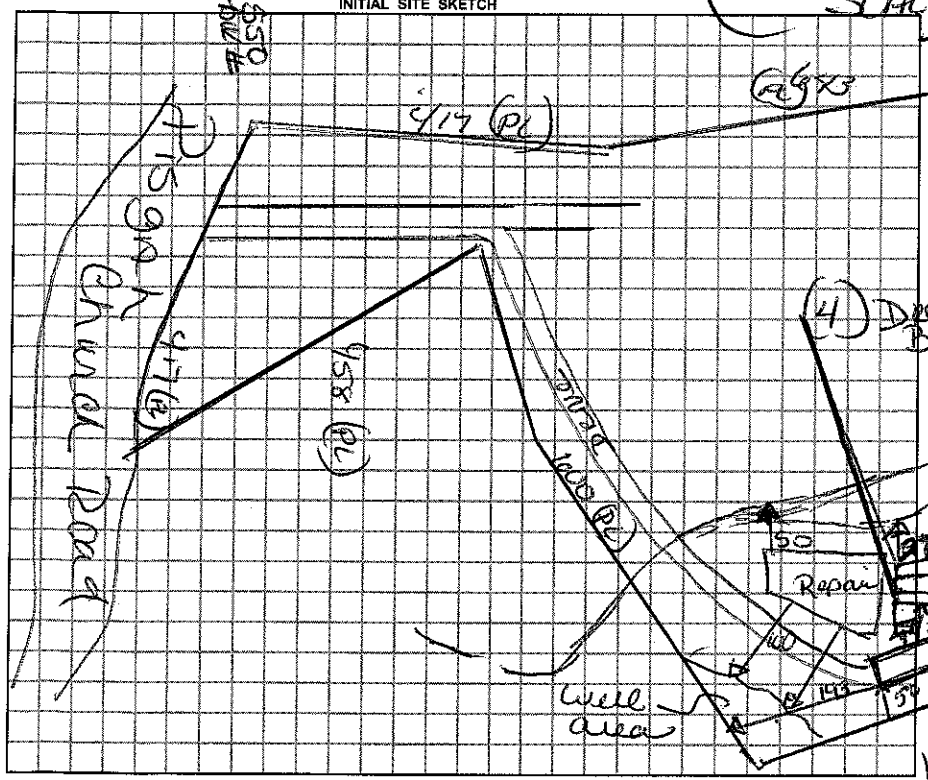

AS BUILT SKETCH

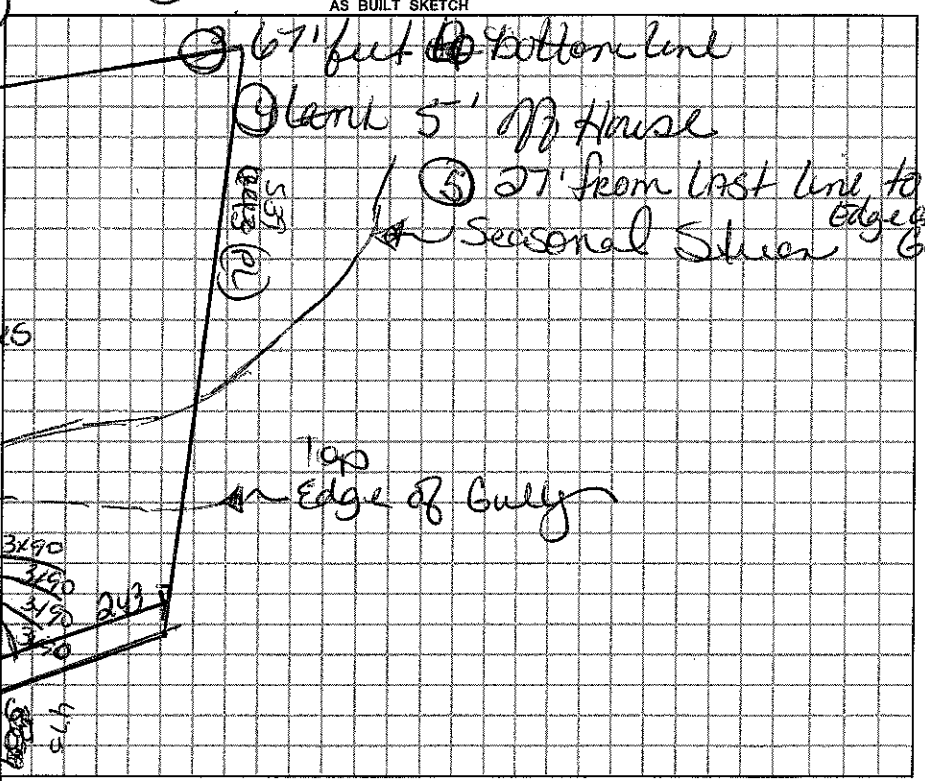

Permit can be suspended or revoked if any false information is supplied toward securing the permit / any unauthorized changes are made to the site / any unauthorized changes are made in the installation of the system.

☐ *IMPROVEMENT PERMIT w / plat valid without expiration.* ☐ *IMPROVEMENT PERMIT w / site plan valid for 60 mos.* ☑ *AUTHORIZATION TO CONSTRUCT valid for period equal to IMPROVEMENT PERMIT-not to exceed 60 mo.*

Owner / Applicant Signature: Date 9-9-09

Improvement Permit by: Date 9-8-09

Authorzation to Construct by: Date 9-8-09

YOU SHOULD CONTACT A LOCATOR SERVICE PRIOR TO ANY EXCAVATION.

Installed by: Scott Greene

Operation Permit by: Date: 10-5-10

Existing System Inspected by: Date:

WHITE COPY Environmental Health YELLOW COPY (Final) Owner / Applicant PINK COPY (Initial) Owner / Applicant