ELL COUNTY HEALTH DEPARTMENT

STATESVILLE 704-878-5305 (P) (F) MOORESVILLE 704-664-5281

IMPROVEMENT PERMIT / AUTHORIZATION TO CONSTRUCT / OPERATION PERMIT / EXISTING SYSTEM INSPECTION

IT # 156784-20 PIN # 4718-38-9665 DATE 7-6-09

NER or APPLICANT Chris A. Davidson Contractors PHONE: Business cell # 704-363-3634 Home: 704-528-6192

OWNER or APPLICANT ADDRESS P.O. Box 5602 Statesville, NC 28687

LOCATION / DIRECTIONS I-77 North to Fisgah Ch. Road TR Bowles Farm Road TR Echo Glen DR 1ST Lot on R

SUBDIVISION BLOCK / SECTION LOT # 1 LOT AREA 10.00 Acres DESIGN FLOW 360gpd L.T.A.R. 0.259 ac/ft2

Septic Tank 1000 Gallons: STB 325 Date 9-16-09

Pump Tank Gallons: P T Date

Pump Make Model Serial #

Nitrification Field No Fields 1 No Lines 4 Linear Feet 480

Trench Width 36" Max. Trench Bottom Depth 30" Gravel Depth 12"

☒ New System ☐ Repair ☐ Expansion System / Type I II III IV V VI

System Description: Gravity - Conventional

Repair System Description: Gravity - Conventional

Maintenance Agreement Required ☐ YES ☒ NO

☒ GRAVITY ☐ PRESSURE

☒ Residence No. Bedrooms 3

☐ Business No. Persons 4

☐ Other No. Employees

☐ Slab ☒ Crawl Space

☐ Basement w/plumbing ☐ Basement w/o plumbing


Water Supply: ☒ Private ☐ Public ☐ Community

Comments / Conditions


See Attached Sketch

Comments / Conditions

INITIAL SITE SKETCH

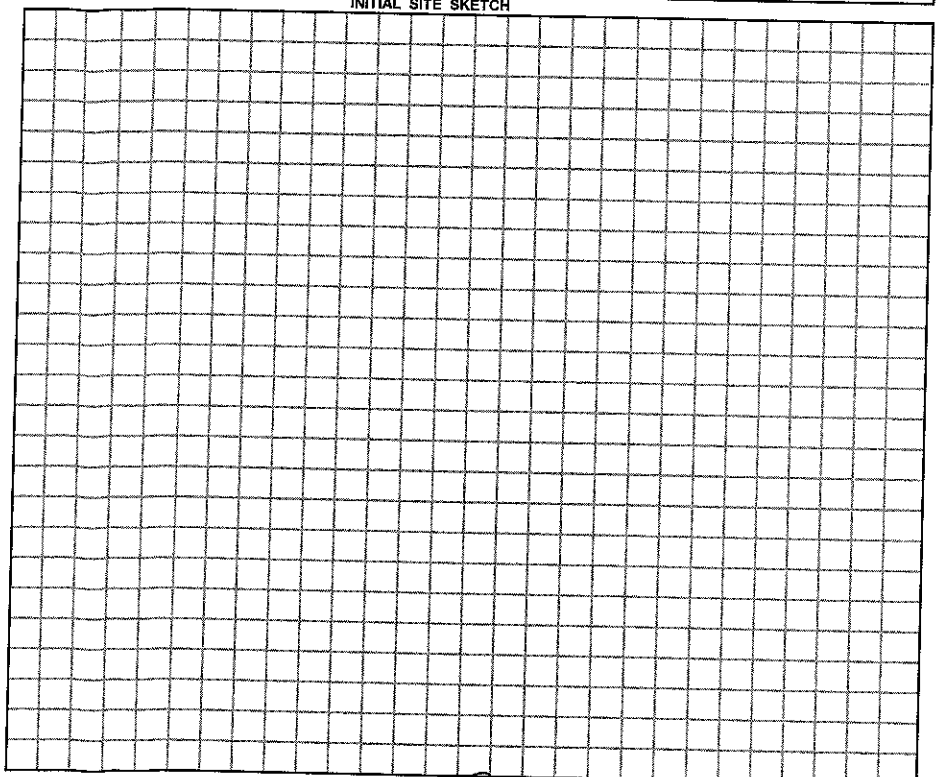

AS BUILT SKETCH

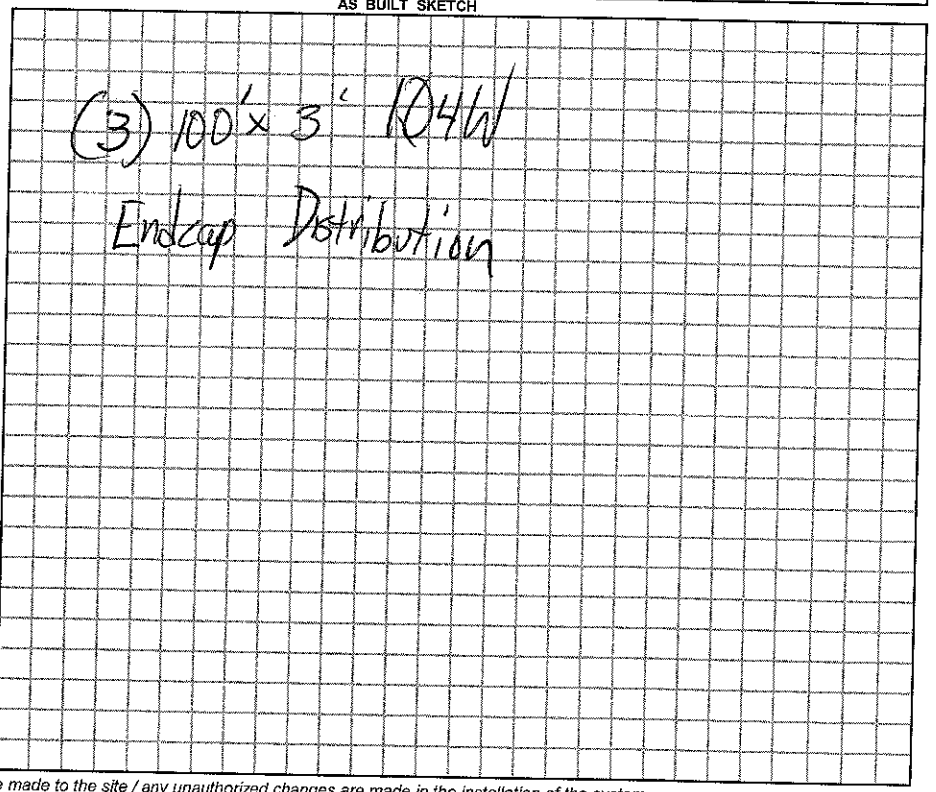

Permit can be suspended or revoked if any false information is supplied toward securing the permit / any unauthorized changes are made to the site / any unauthorized changes are made in the installation of the system.

☐ *IMPROVEMENT PERMIT w / plat valid without expiration.* ☒ *IMPROVEMENT PERMIT w / site plan valid for 60 mos.* ☐ *AUTHORIZATION TO CONSTRUCT valid for period equal to IMPROVEMENT PERMIT-not to exceed 60 mo.*

Owner / Applicant Signature: Chris A. Davidson Date 7/9/09

Improvement Permit by: Fred Hammes / DHuman Date 7-6-09

Authorzation to Construct by: DHuman Date 7-7-09


YOU SHOULD CONTACT A LOCATOR SERVICE PRIOR TO ANY EXCAVATION.

Installed by: Rowan Septic

Operation Permit by: James Date: 10-30-09

Existing System Inspected by: Date:

WHITE COPY Environmental Health YELLOW COPY (Final) Owner / Applicant PINK COPY (Initial) Owner / Applicant

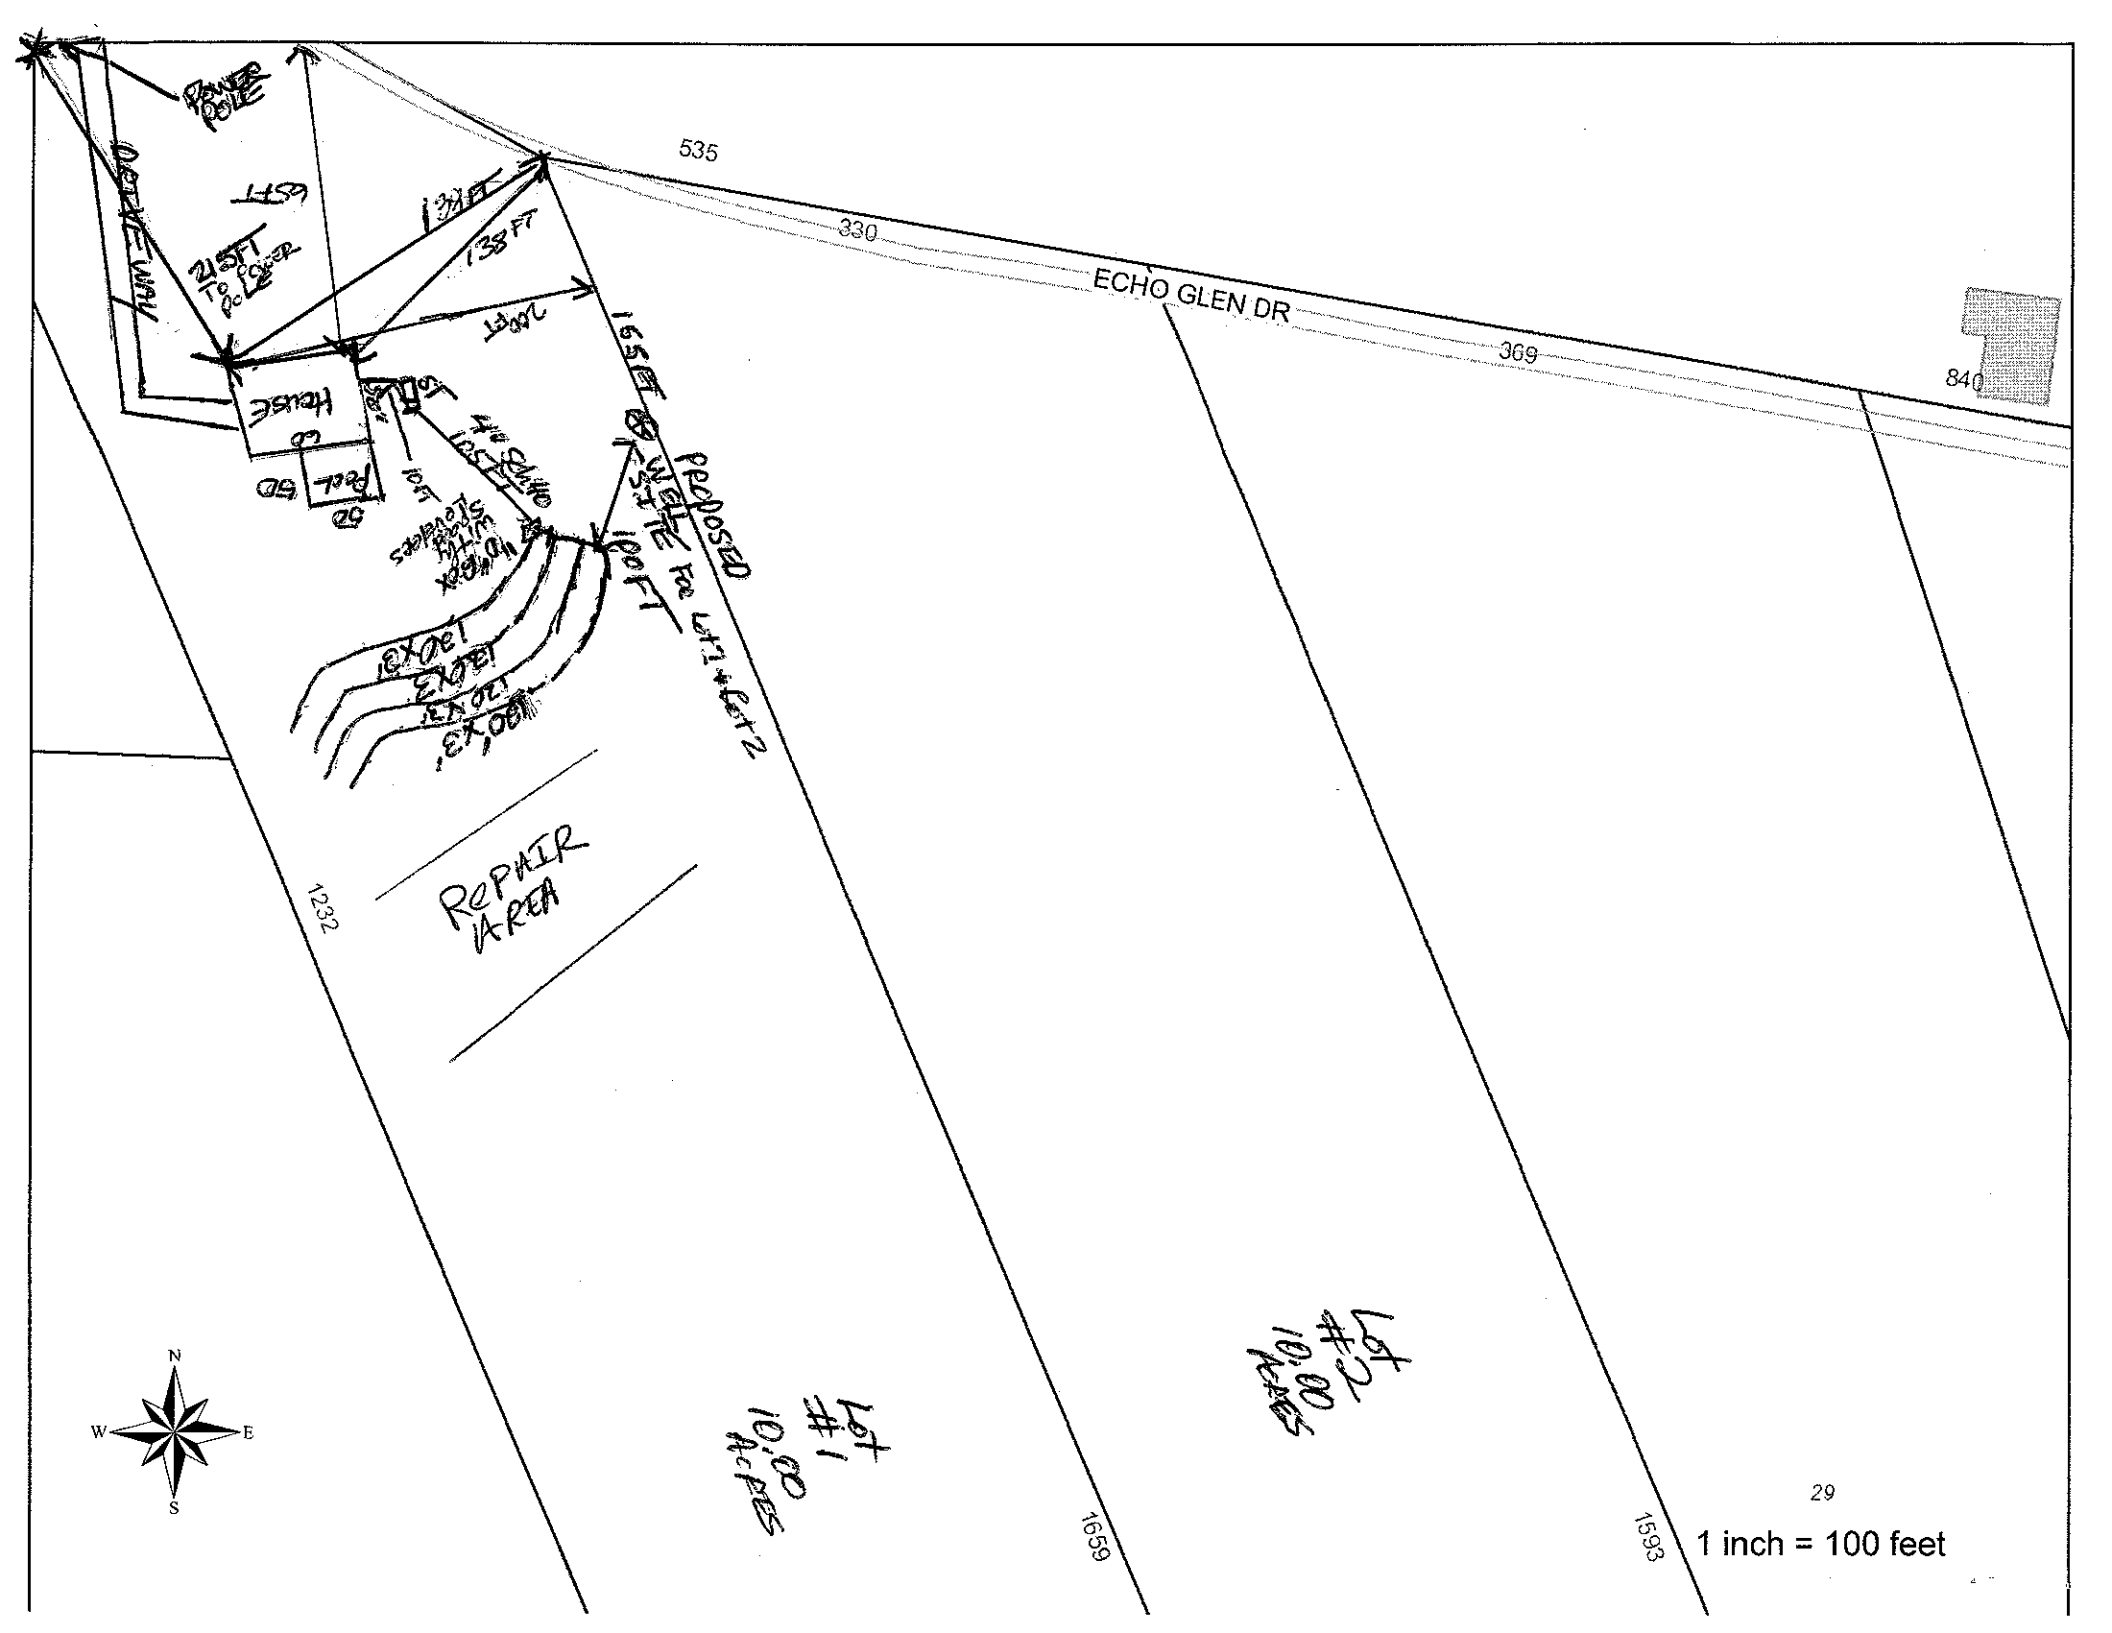
POWER POLE
535
330
ECHO GLEN DR
369
840
65FT
215FT
138FT
200FT
165FT
PROPOSED WELL SITE for Lot 1 & Lot 2
100 FT
House
Pool
50
50
Lot
10'x10' Box with Sloped Sidewalls
REPAIR AREA
1232
Lot #1 10.00 Acres
Lot #2 10.00 Acres
1659
1593
29
N
W
E
S
1 inch = 100 feet