IREDELL COUNTY HEALTH DEPARTMENT

Statesville Phone TR 3-7271 Mooresville Phone NO 3-1271

PERMIT TO INSTALL SEPTIC TANK

Permit NO. _____ Permit Date June 14 1963

Owner Hill Millsaps. Address Central

Installed By C Hoke Address _____


Location of Property Out 115 to Pisgah Ch Rd R, at X Rd toward Central school - 1st brick on R

Tank		Capacity		Length of Lines		Fixtures	
Block	( )	800	( )	150	( )	No. of Baths	(2)
Precast	(✓)	900	( )	175'	( )	Dishwasher	( )
		1000	(✓)	200'	( )	Garbage Grdr.	( )
		1100	( )	225'	(✓)	Auto-Washer	( )
		1200	( )	250'	( )	Other	_____
		Other	_____	Other	_____		

NOTIFY HEALTH DEPARTMENT AT LEAST EIGHT HOURS BEFORE TANK IS TO BE INSPECTED.

Final Inspection 6-14 1963 Approved (✓) Disapproved ( )

Remarks well 50'

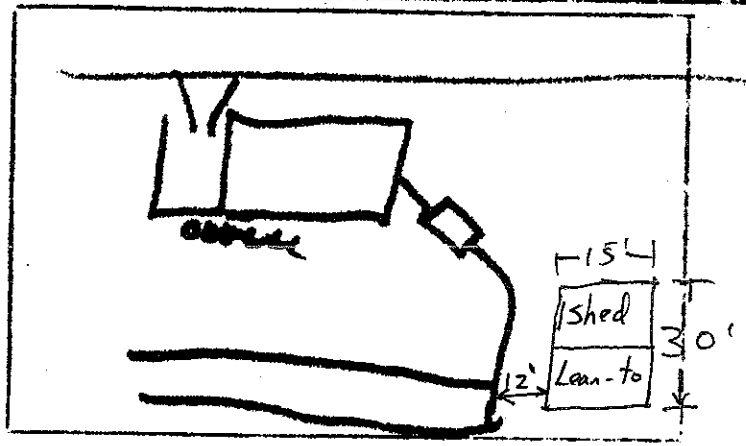

Sketch of Installation

Location of the proposed Shed + Lean to addition does not appear to impact the existing on-site septic system.**NOTE: _____

_____ REHS

Date: April 3, 2012

ICHD-Environmental Health Division

R.A.

Sanitarian