IREDELL COUNTY HEALTH DEPARTMENT

Statesville Office (704) 878-5305 Mooresville Office (704) 660-3625 PERMIT # 205302

IMPROVEMENT PERMIT / AUTHORIZATION TO CONSTRUCT / OPERATION PERMIT / EXISTING SYSTEM

PIN # 4718756235 74-5907

APPLICANT: Laura A. Gregory APPLICANT ADDRESS: 153 Clio Ln.

SITE ADDRESS: 108 Clio Ln. - Stvl 28625 PHONE: 704-876-1071 ALT. PHONE: N/A

SITE DIRECTIONS: Hwy 115 N TL Pisgah Church Rd TL Clio Ln.


SUBDIVISION: N/A - Bryant Compton SECTION: N/A LOT # N/A 1 LOT AREA: 1.0 acre DESIGN FLOW: 360gpd L.T.A.R.: 0.275

Septic Tank	1000	(gal)	STB# 012-1000	Date	7-12-14	☑ New System	☐ Repair	☐ Expansion	System Type: I II (III) IV V VI	☑ Residence	No. Bedrooms 3
Pump Tank		(gal)	PT	Date		System Description:	25% Reduction			☐ Business	No. Persons 6
Pump Make		Model		Serial #		Repair System Description:	50% Reduction			☐ Other	No. Employees
# Nitrification Fields	1	# Lines	3	Linear Ft:	328	Maintenance Agreement Required:	☐ YES	☑ NO		☐ Slab	☑ Crawl Space
Trench Width	36"	Max. Trench Bottom Depth	36"	Gravel Depth	N/A		☑ GRAVITY	☐ PRESSURE		☐ Basement w/plumbing	☐ Basement w/o plumbing

Water Supply: ☑ Private ☐ Public ☐ Community

Comments / Conditions: Install a 25% Reduction system on contour with serial distribution. Grade out existing terrace.

INITIAL SITE SKETCH

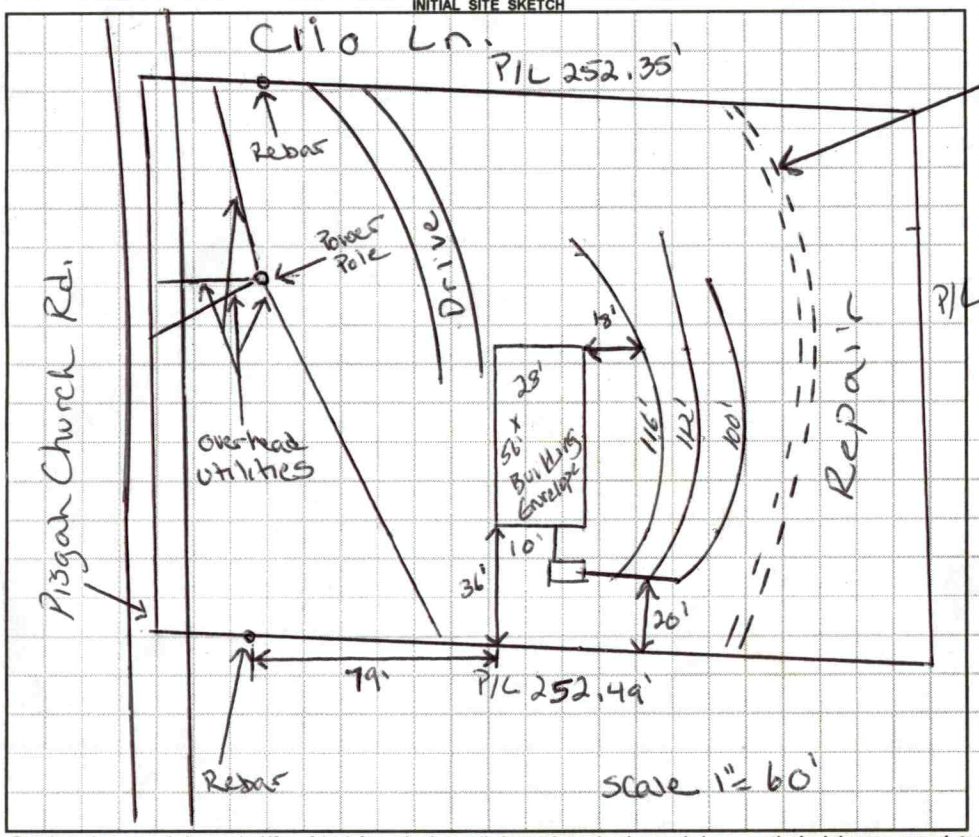

AS BUILT SKETCH

- Yellow Tuff-Ite filter installed
- 2" PVC ST marker installed
- Quick 4 Chambers installed
- Installed as drawn

Permit can be suspended or revoked if any false information is supplied toward securing the permit / any unauthorized changes are made to the site / any unauthorized changes are made in the installation of the system. **CONTACT A LOCATOR SERVICE PRIOR TO ANY EXCAVATION**

☐ **IMPROVEMENT PERMIT** *with plat valid without expiration.* ☑ **IMPROVEMENT PERMIT** *with site plan valid for 60 mos.* ☑ **AUTHORIZATION TO CONSTRUCT** *valid for period equal to IMPROVEMENT PERMIT--not to exceed 60 mo.*

Owner / Applicant Signature: Laura A. Gregory Date: 9-10-14 Installed by: David Yountz

IMPROVEMENT PERMIT by: Justin Henderson Date: 9-10-14 OPERATION PERMIT by: Justin Henderson Date: 10-29-14

AUTHORIZATION TO CONSTRUCT by: Justin Henderson Date: 9-10-14 Existing System Inspected by: Date:

Health Dept. Copy - WHITE Applicant (Final Approval) - YELLOW Applicant (Conditional Approval) - PINK

