IREDELL COUNTY HEALTH DEPARTMENT

STATESVILLE 704-878-5305 MOORESVILLE 704-664-5281

IMPROVEMENT PERMIT / AUTHORIZATION TO CONSTRUCT / OPERATION PERMIT / EXISTING SYSTEM INSPECTION

PERMIT# 136371 PIN# 4718-79-[redacted]7629 DATE 6-24-06

OWNER OR APPLICANT STACY L. & CAROL F. ROBINSON PHONE: Business 704-876-4172 Home

ADDRESS 221 HONEYPATH LANE, STATESVILLE, NC 28625

LOCATION NC 115 N, TL HILL DAIRY RD, TL FOX BOTTOMS RD, TL EAGLES NEST RD, BEAR LEFT TO END

SUBDIVISION BLOCK / SECTION LOT LOT AREA 7.0 ACRES SITE CLASS. PS DESIGN FLOW 600 L.T.A.R. 0.30 GPD/FT2

Septic Tank: 1500 Gallons; STB 338 Date

Pump Tank: Gallons; PT Date

Pump Make: Model Serial No.

Nitrification Field: No Fields 1 Square Feet EQ. P 2000 Linear Feet 500

No Lines 4 Trench Width 36" Max Trench Bottom Depth 28" Gravel Depth N/A ☑ Gravity ☐ Pressure

☐ New System ☐ Repair ☐ Expansion System Type: I II (III) IV V VI

System Description: 25% REDUCTION GRAVITY

Repair System Description: LOW PRESSURE PIPE

Maintenance Agreement Required: ☐ Yes ☑ No

☑ House/Mod. Home ☐ Mobile Home ☐ Business ☐ Other W/ SHOP

No. Bedrooms 5 No. Persons No. Employees

Water Supply: ☑ Individual ☐ Public ☐ Community WELL


☐ Slab ☐ Crawl Space ☑ Basement w/plumbing ☐ Basement wo/plumbing

Comments:/Conditions:

Comments:/Conditions: SYSTEM SIZED FOR DOMESTIC WASTEWATER ONLY -

INITIAL SITE SKETCH

AS BUILT SKETCH

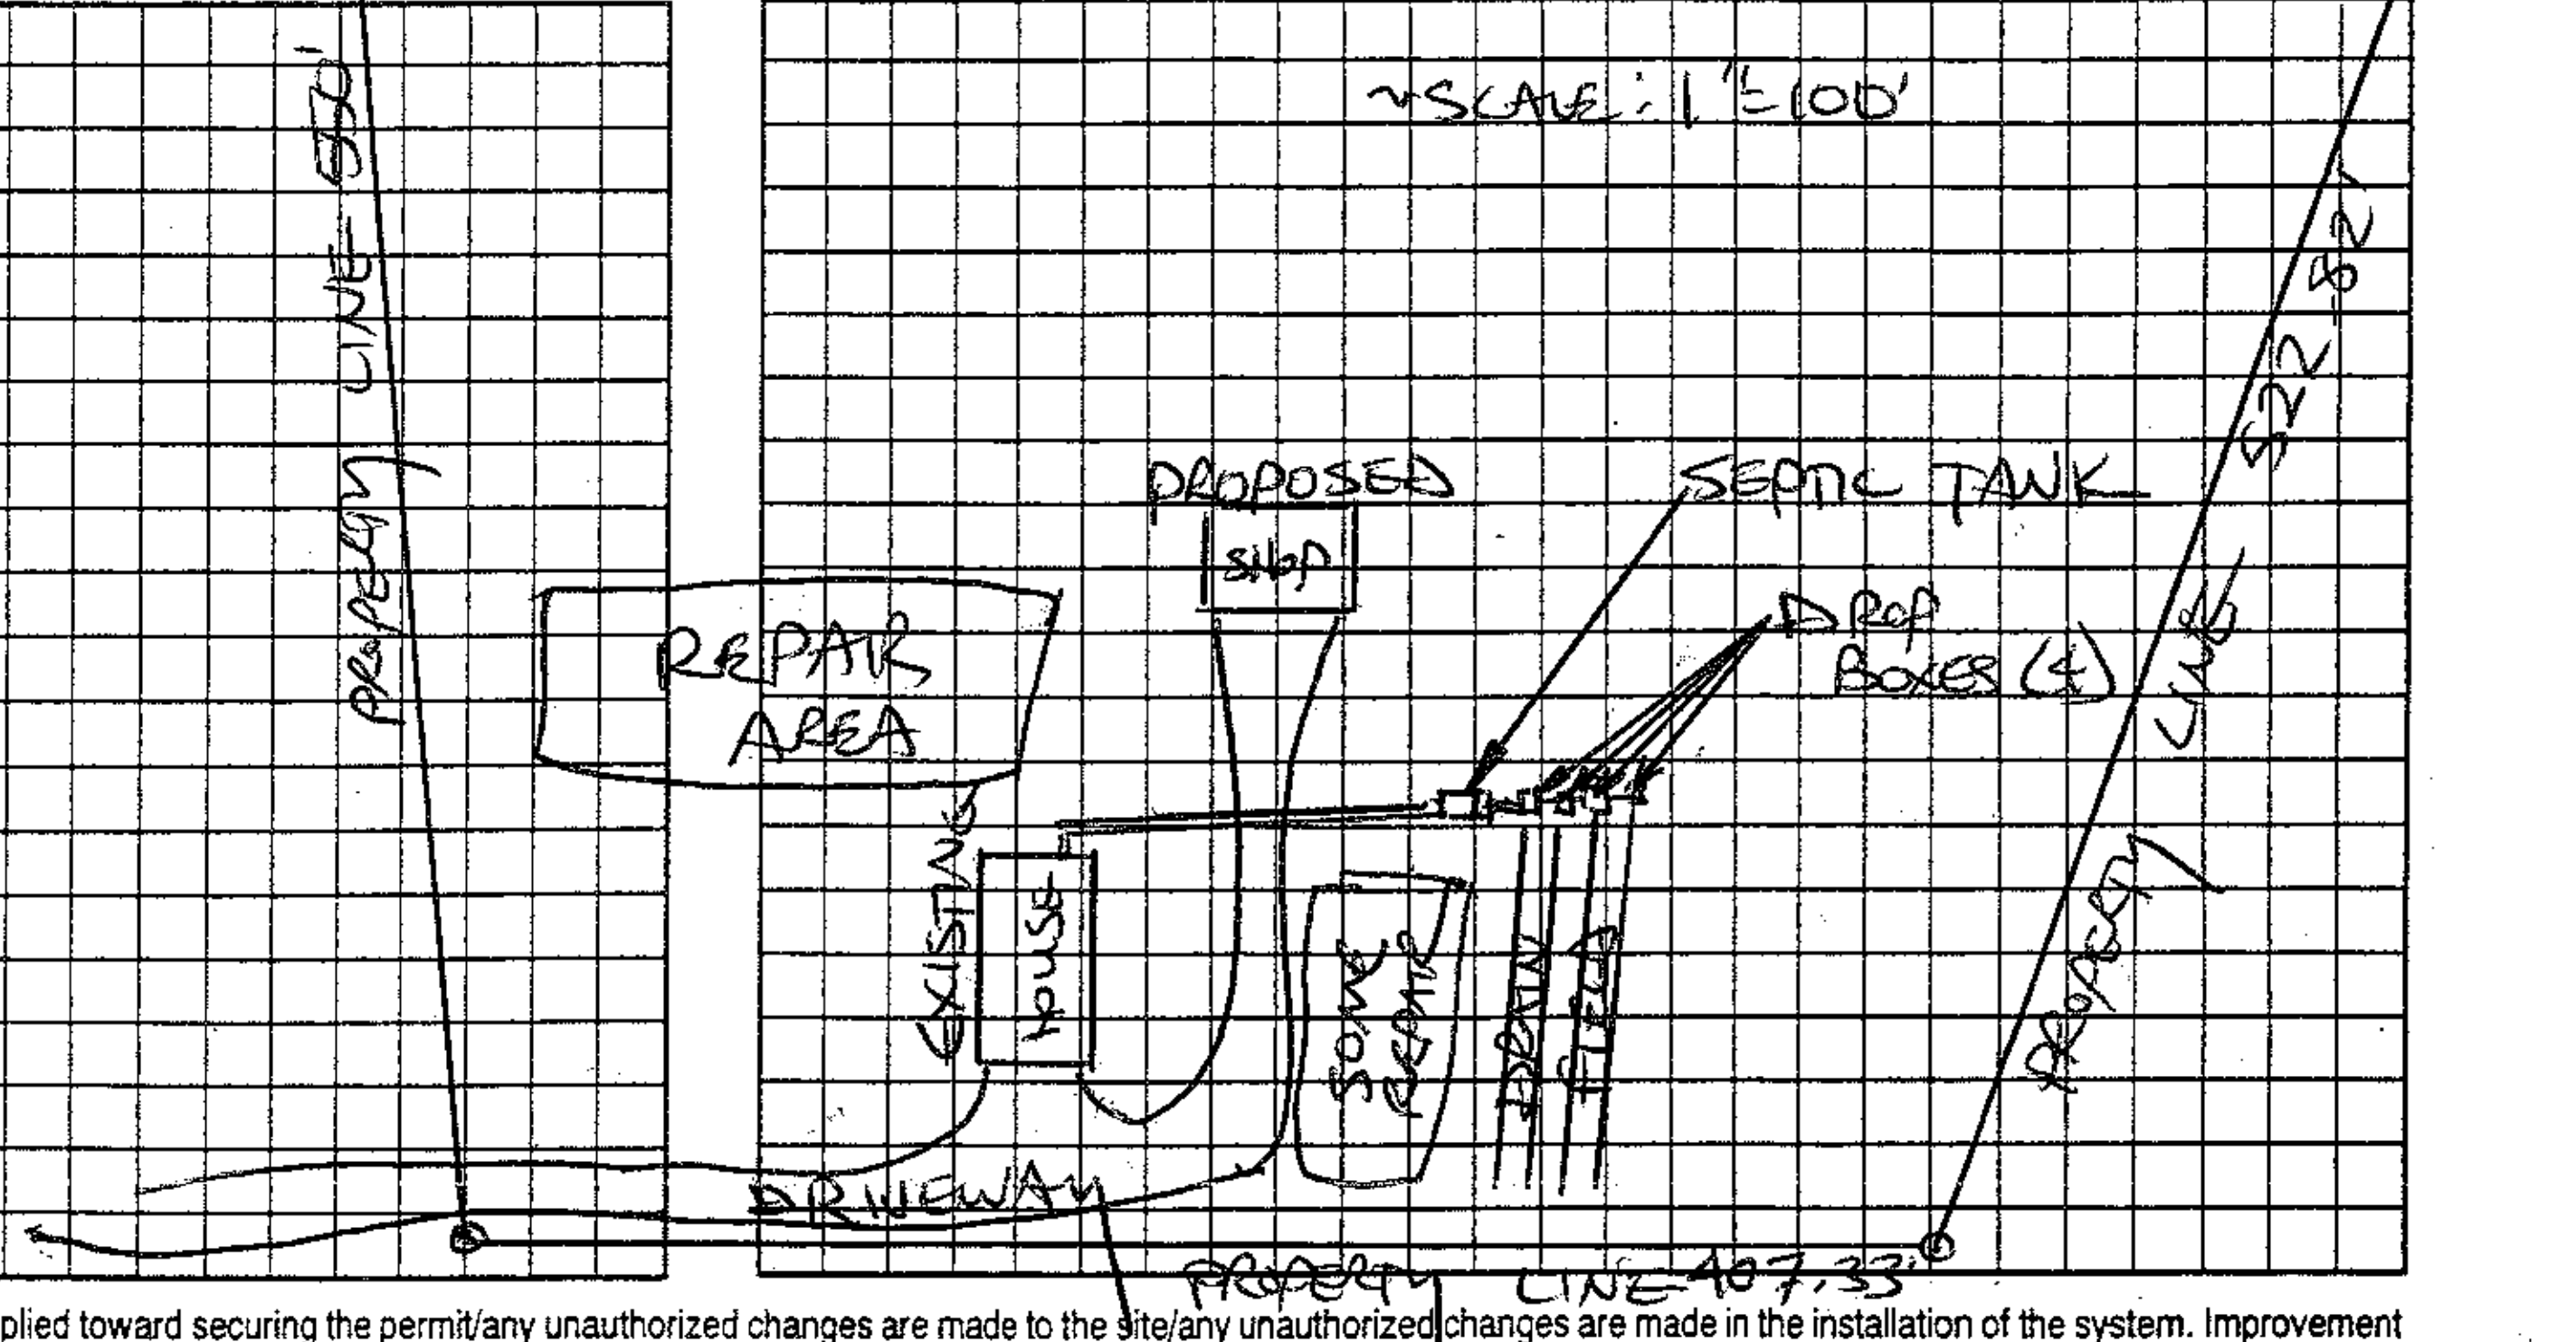

Permit can be suspended or revoked if any false information is supplied toward securing the permit/any unauthorized changes are made to the site/any unauthorized changes are made in the installation of the system. Improvement Permit with plat valid without expiration ☐ Improvement Permit with site plan valid for sixty months ☐ Authorization to Construct is valid for a period equal to that of Improvement Permit – not to exceed sixty months.

Signed: [signature] date 6-27-06 Installed by:

Improvement Permit by: date Operation Permit by: date

Authorization to Construct by: date Existing System Inspection by: STEVE HEDRICK date 6-24-06

HEALTH DEPT. COPY: WHITE OWNER COPY (FINAL): YELLOW OWNER COPY (INITIAL): PINK