IREDELL COUNTY HEALTH DEPARTMENT

STATESVILLE 704-878-5305 MOORESVILLE 704-664-5281

IMPROVEMENT PERMIT / AUTHORIZATION TO CONSTRUCT / OPERATION PERMIT / EXISTING SYSTEM INSPECTION

PERMIT# REPAIR PIN# 4718 85 9830 DATE 12-27-02

OWNER OR CONTRACTOR WILLIE GRAY JOHNSON PHONE: Business Home 704-876-4406

ADDRESS 254 PISGAH CHURCH ROAD, STATESVILLE, NC 28625-1260

LOCATION NC 115 North, TL PISGAH CH. ROAD, 0.6 MILE ON RIGHT AT BOX # 254

SUBDIVISION BLOCK / SECTION LOT LOT AREA 2.03 ACRES SITE CLASS. PS DESIGN FLOW 240 L.T.A.R. ENSTAR 0.3

Septic Tank: 1000 Gallons; STB 794 Date 7-26-02 ☐ New System ☑ Repair System Type: I, II, III, IV, V, VI

Pump Tank: Gallons; PT Date System Description: CONVENTIONAL, GRAVITY

Pump Make: Model Serial No. Repair System Description: CONVENTIONAL, GRAVITY

Nitrification Field: No Fields 1 Square Feet 750 Linear Feet 250 Maintenance Agreement Required: ☐ Yes ☑ No

No Lines THREE Trench Width 36" Max Trench Bottom Depth 36" Gravel Depth 12"

☑ House/Mod. Home No. Bedrooms 2

☐ Mobile Home No. Bathrooms 1

☐ Business No. Employees

☐ Other

☐ Slab ☐ Crawl Space ☐ Basement w/plumbing ☑ Basement wo/plumbing

Water Supply: ☑ Individual ☐ Public ☐ Community WELL


Comments:/Conditions:

ABANDON OLD SEPTIC SYSTEM.

Comments:/Conditions: SEPTIC TANK WITH MARKER INSTALLED USING "ZABEL" FILTER

SCALE: 1"=60'

INITIAL SITE SKETCH

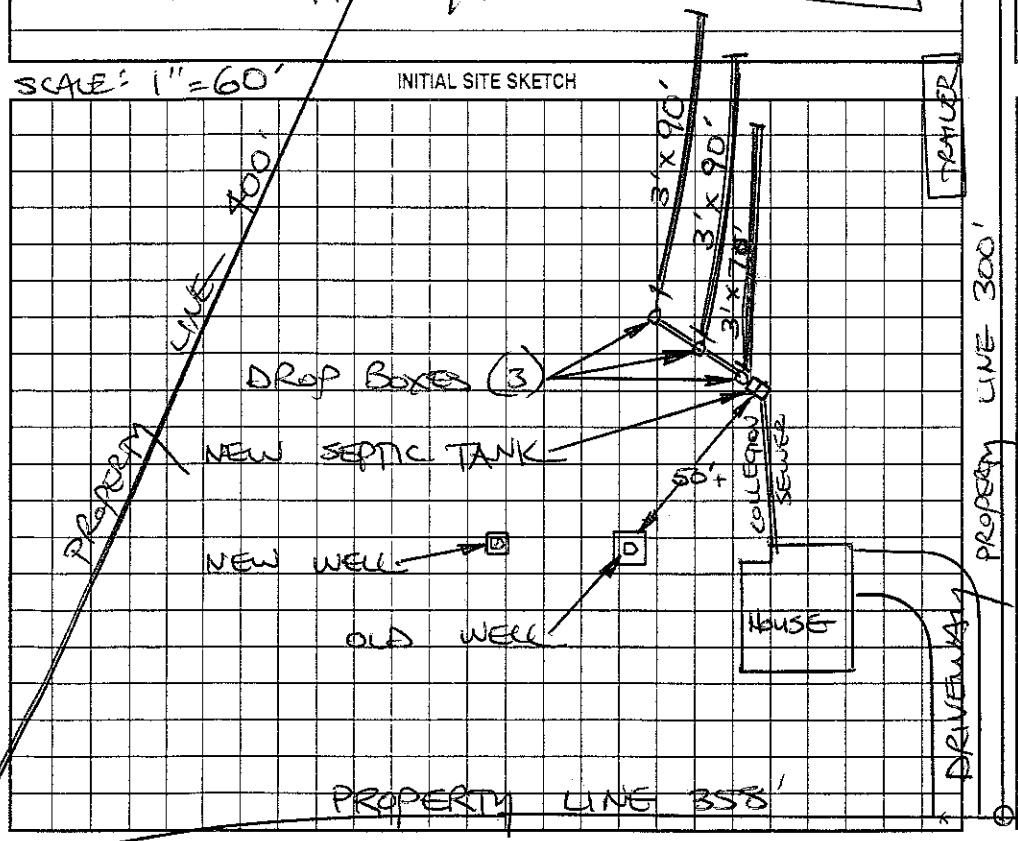

AS BUILT SKETCH

SYSTEM INSTALLED ACCORDING TO INITAL SITE SKETCH

Permit can be suspended or revoked if any false information is supplied toward securing the permit, any unauthorized changes are made to the site, any unauthorized changes are made in the installation of the system. Improvement Permit with plat valid without expiration. Improvement Permit with site plan valid for sixty months. Authorization to Construct is valid for a period equal to that of Improvement Permit – not to exceed sixty months.

Signed: Willie Johnson date 12-27-02 Installed by: ANDY DANIELS

Improvement Permit by: STEVE HEDRICK date 12-27-02 Operation Permit by: STEVE HEDRICK date 1-7-03

Authorization to Construct by: STEVE HEDRICK date 12-27-02 Existing System Inspection by: date

HEALTH DEPT. COPY: WHITE OWNER COPY (FINAL): YELLOW OWNER COPY (INITIAL): PINK