IREDELL COUNTY HEALTH DEPARTMENT

Statesville Office (704) 878-5305 Mooresville Office (704) 660-3625 PERMIT # 178383

IMPROVEMENT PERMIT / AUTHORIZATION TO CONSTRUCT / OPERATION PERMIT / EXISTING SYSTEM

PIN # 4718864338

APPLICANT: Nancy Cole APPLICANT ADDRESS: 118 Bore Dr.

SITE ADDRESS: 118 Bore Dr. PHONE: 704-876-2425 ALT. PHONE: N/A


SITE DIRECTIONS: Hwy 115 N TL Pisgah Ch. Rd. TR Bore Dr.

SUBDIVISION: N/A SECTION: N/A LOT # N/A LOT AREA: 2.86 acres DESIGN FLOW: 360gpd L.T.A.R.: Existing


Septic Tank	1000 (gal)	STB 1000	Date 7-18-12	☐ New System	☑ Repair	☐ Expansion	System Type: I (II) III IV V VI	☑ Residence	No. Bedrooms 3	Water Supply
Pump Tank	(gal)	PT	Date	System Description:				☐ Business	No. Persons	☑ Private
Pump Make	Model		Serial #	Repair System Description: TANK				☐ Other	No. Employees	☐ Public
# Nitrification Fields 6x	# Lines 6x		Linear Ft: 6x	Maintenance Agreement Required:	☐ YES	☑ NO		☐ Slab	☐ Crawl Space	☐ Community
Trench Width 6x	Max. Trench Bottom Depth 6x		Gravel Depth 6x		☑ GRAVITY	☐ PRESSURE		☐ Basement w/plumbing		☑ Basement w/o plumbing

Comments / Conditions: Pump + crush old septic tank. Install new septic tank @ location shown below. Connect new septic tank to existing drainfield. Supply line from tank to drainfield shall be of ductile iron or equivalent at all locations it passes under driveway

INITIAL SITE SKETCH

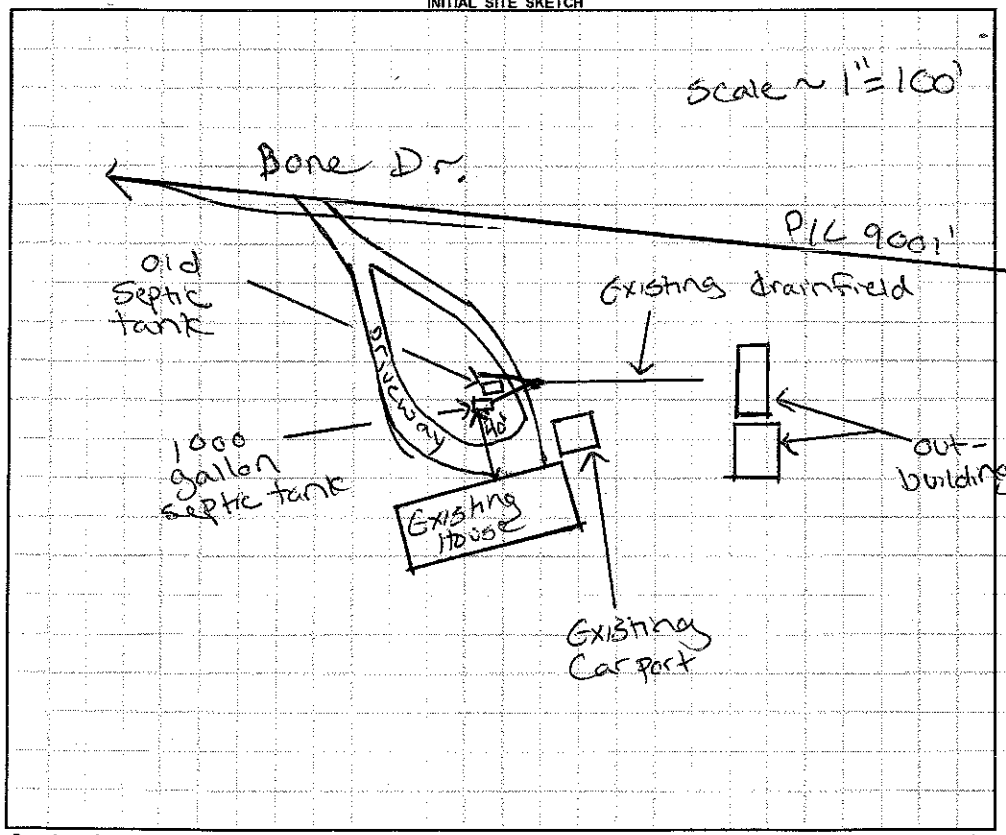

AS BUILT SKETCH

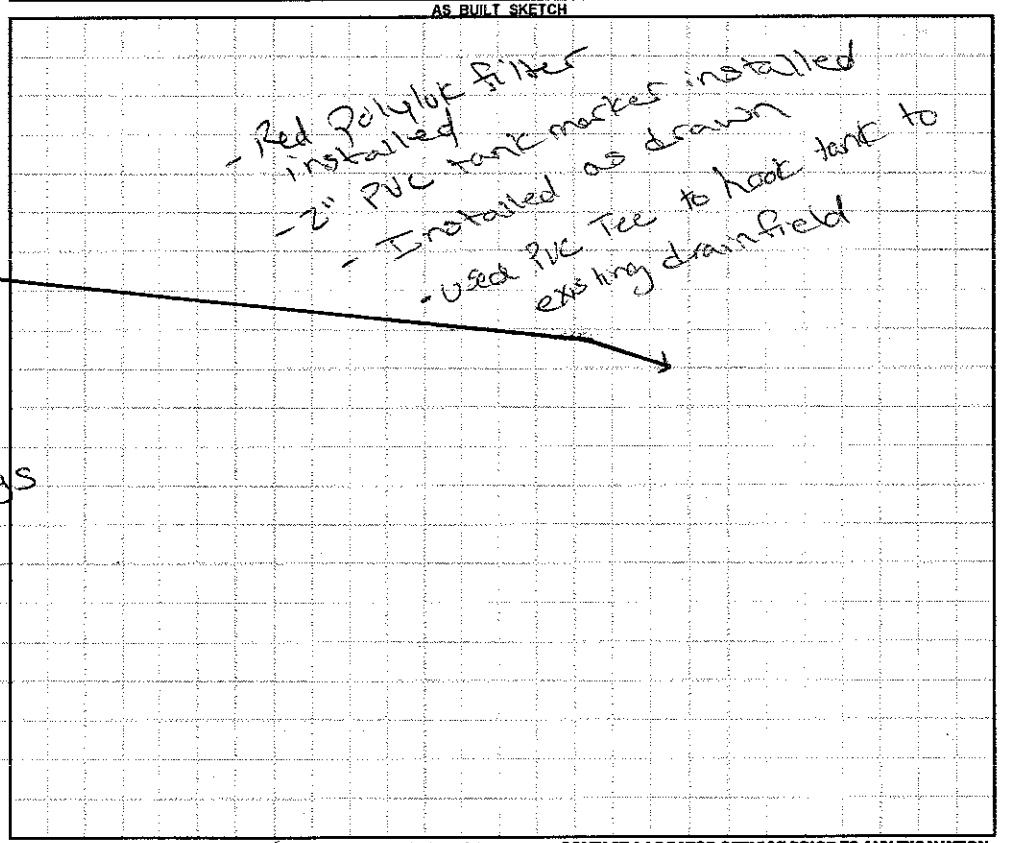

Permit can be suspended or revoked if any false information is supplied toward securing the permit / any unauthorized changes are made to the site / any unauthorized changes are made in the installation of the system. **CONTACT A LOCATOR SERVICE PRIOR TO ANY EXCAVATION**

☐ **IMPROVEMENT PERMIT** *with plat valid without expiration.* ☑ **IMPROVEMENT PERMIT** *with site plan valid for 60 mos.* ☑ **AUTHORIZATION TO CONSTRUCT** *valid for period equal to IMPROVEMENT PERMIT--not to exceed 60 mo.*

Owner / Applicant Signature: Nancy N Cole Date: 5-2-13 Installed by: Steve Jordan

IMPROVEMENT PERMIT by: Justin Henderson Date: 5-2-13 OPERATION PERMIT by: Justin Henderson Date:

AUTHORIZATION TO CONSTRUCT by: Justin Henderson Date: 5-2-13 Existing System Inspected by: Date:

Health Dept. Copy - WHITE Applicant (Final Approval) - YELLOW Applicant (Conditional Approval) - PINK