IREDELL COUNTY HEALTH DEPARTMENT

Statesville Office (704) 878-5305 Mooresville Office (704) 660-3625 PERMIT # 202253

IMPROVEMENT PERMIT / AUTHORIZATION TO CONSTRUCT / OPERATION PERMIT / EXISTING SYSTEM

PIN # 4718864338.272

APPLICANT: Chris Goforth APPLICANT ADDRESS: 118 Bone Dr.

SITE ADDRESS: 272 Pisgah Church Rd. PHONE: 704-902-1692 ALT. PHONE: N/A


SITE DIRECTIONS: Hwy 115 N TL Pisgah Church Rd.

SUBDIVISION: N/A SECTION: N/A LOT # N/A LOT AREA: 28.6 acres DESIGN FLOW: 360gpd L.T.A.R.: 0.275

Septic Tank	1000	(gal)	STB	1012-1000	Date	1-19-14	☑ New System ☐ Repair ☐ Expansion	System Type: I II ☒ III IV V VI	☑ Residence	No. Bedrooms	3	Water Supply
Pump Tank		(gal)	PT		Date		System Description: 25% Reduction		☐ Business	No. Persons	6	☑ Private
Pump Make			Model		Serial #		Repair System Description: 25% Reduction		☐ Other	No. Employees		☐ Public
# Nitrification Fields	1		# Lines	3	Linear Ft:	328	Maintenance Agreement Required: ☐ YES ☑ NO		☐ Slab	☑ Crawl Space		☐ Community
Trench Width	36"		Max. Trench Bottom Depth	36"	Gravel Depth	N/A	☑ GRAVITY ☐ PRESSURE		☐ Basement w/plumbing	☐ Basement w/o plumbing		

Comments / Conditions: Install a 25% Reduction system on contour with serial distribution.

INITIAL SITE SKETCH

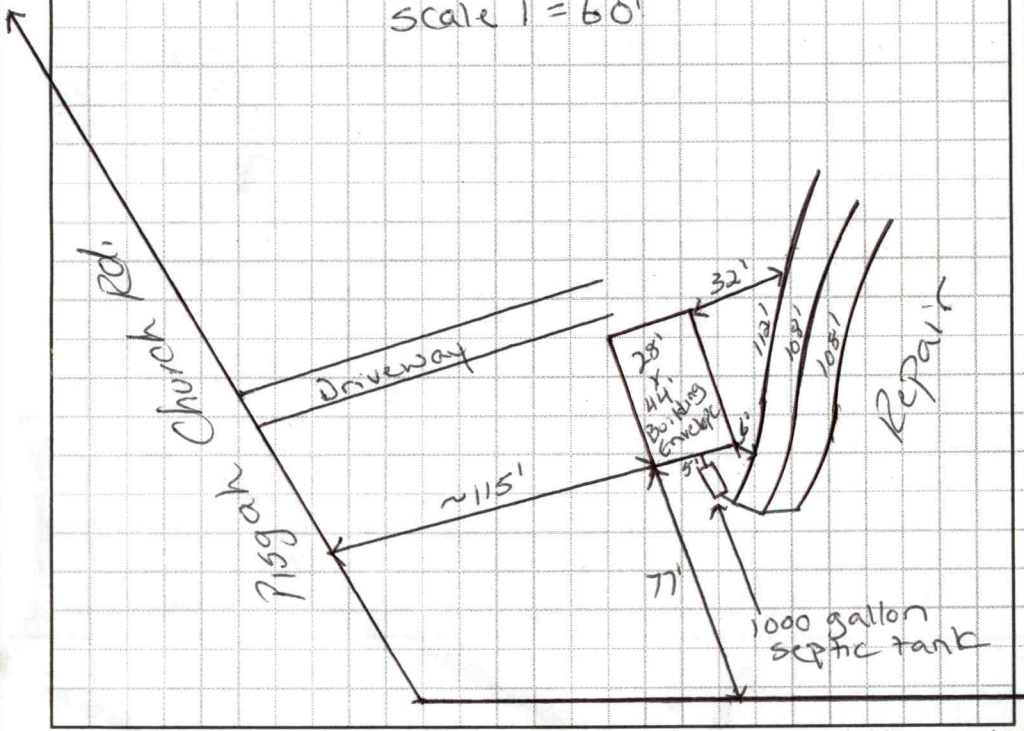

AS BUILT SKETCH

- yellow tuffstite filter installed
- Quick 4 chambers installed
- 2" PVC tank marker installed
- Installed as drawn

Permit can be suspended or revoked if any false information is supplied toward securing the permit / any unauthorized changes are made to the site / any unauthorized changes are made in the installation of the system. **CONTACT A LOCATOR SERVICE PRIOR TO ANY EXCAVATION**

☐ **IMPROVEMENT PERMIT** *with plat* valid without expiration. ☑ **IMPROVEMENT PERMIT** *with site plan* valid for 60 mos. ☑ **AUTHORIZATION TO CONSTRUCT** valid for period equal to IMPROVEMENT PERMIT--not to exceed 60 mo.

Owner / Applicant Signature: Date: Installed by: Steve Jordan

IMPROVEMENT PERMIT by: Justin Henderson Date: 4-10-14 OPERATION PERMIT by: Justin Henderson Date: 5-20-14

AUTHORIZATION TO CONSTRUCT by: Justin Henderson Date: 4-10-14 Existing System Inspected by: Date:

Health Dept. Copy - WHITE Applicant (Final Approval) - YELLOW Applicant (Conditional Approval) - PINK

