IREDELL COUNTY HEALTH DEPARTMENT

Statesville Office (704) 878-5305 Mooresville Office (704) 660-3825 PERMIT # 203719

IMPROVEMENT PERMIT / AUTHORIZATION TO CONSTRUCT / OPERATION PERMIT / EXISTING SYSTEM

PIN # 4718864338

APPLICANT: Phil Smith APPLICANT ADDRESS: 582 New Salem Rd Statesville

SITE ADDRESS: 118 Bone Dr. Statesville NC 28625 PHONE: 704-450-8495 ALT. PHONE: 704-902-1692

SITE DIRECTIONS: Take Hwy 115 N, Left on Pisgah Church Rd Approx 1 mile Bone Dr on right 1st drive on right

SUBDIVISION: N/A SECTION: N/A LOT # N/A LOT AREA: 28.6ac DESIGN FLOW: 360 L.T.A.R.: EX

Septic Tank EX (gal) STB Date

Pump Tank (gal) PT Date

Pump Make Model Serial #

Nitrification Fields # Lines Linear Ft:

Trench Width EX Max. Trench Bottom Depth EX Gravel Depth EX

☐ New System ☐ Repair ☐ Expansion System Type: I (II) III IV V VI

System Description: Existing

Repair System Description:

Maintenance Agreement Required: ☐ YES ☒ NO

☒ GRAVITY ☐ PRESSURE

☒ Residence No. Bedrooms 3

☐ Business No. Persons 6

☐ Other No. Employees

☐ Slab ☒ Crawl Space

☐ Basement w/plumbing ☐ Basement w/o plumbing


Water Supply: ☒ Private ☐ Public ☐ Community

Comments / Conditions:

Number of bedrooms can not increase to ≥3 bedroom. Addition must be ≥5' from any part of STS and ≥25' from any well.

INITIAL SITE SKETCH

AS BUILT SKETCH

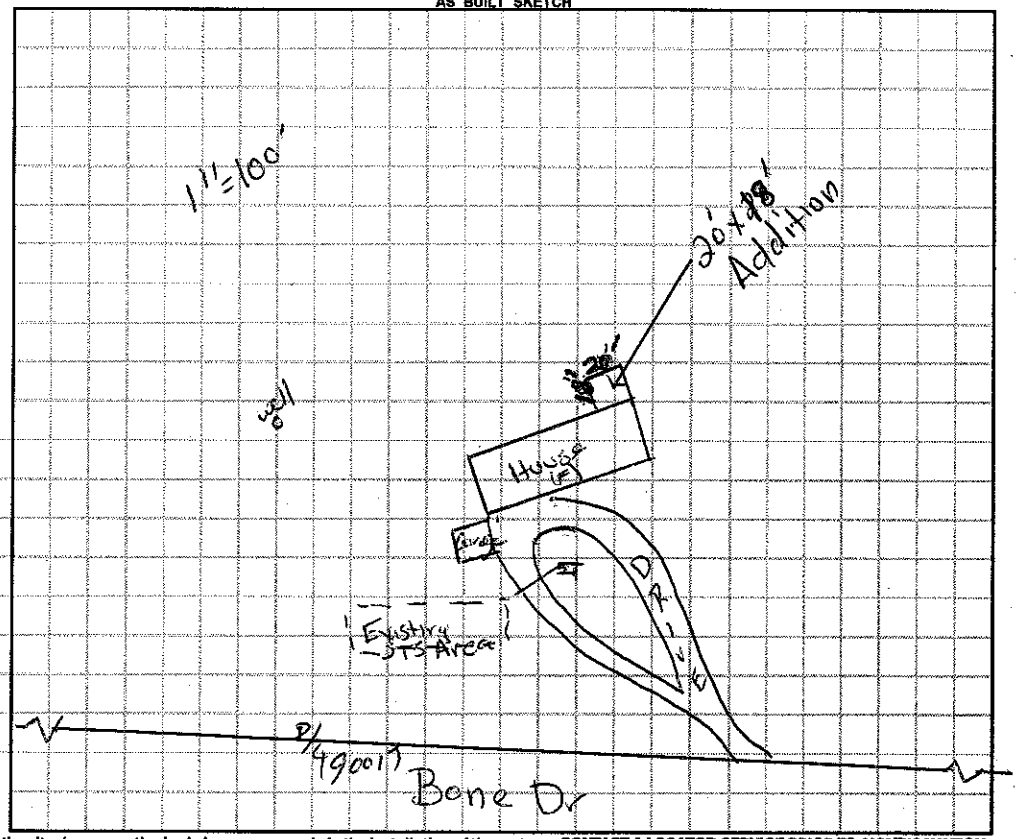

Permit can be suspended or revoked if any false information is supplied toward securing the permit / any unauthorized changes are made to the site / any unauthorized changes are made in the installation of the system. **CONTACT A LOCATOR SERVICE PRIOR TO ANY EXCAVATION**

☐ **IMPROVEMENT PERMIT** *with plat valid without expiration.* ☐ **IMPROVEMENT PERMIT** *with site plan valid for 60 mos.* ☐ **AUTHORIZATION TO CONSTRUCT** *valid for period equal to IMPROVEMENT PERMIT--not to exceed 60 mo.*

Owner / Applicant Signature: Phil Smith Date: Installed by:

IMPROVEMENT PERMIT by: Date: OPERATION PERMIT by: Date:

AUTHORIZATION TO CONSTRUCT by: Date: Existing System Inspected by: Date: 06/24/14

Health Dept. Copy - WHITE Applicant (Final Approval) - YELLOW Applicant (Conditional Approval) - PINK