THIS PERMIT VOIDS PREVIOUS ISSUED 7-16-01

IREDELL COUNTY HEALTH DEPARTMENT

STATESVILLE 704-878-5305 (C) MOORESVILLE 704-664-5281

IMPROVEMENT PERMIT / AUTHORIZATION TO CONSTRUCT / OPERATION PERMIT / EXISTING SYSTEM INSPECTION

PERMIT# 101252 PIN# 4718-91-8644 DATE 7-19-02

OWNER OR CONTRACTOR MICHAEL HENDERSON PHONE: Business 704-871-1536 Home 704-878-0357

ADDRESS 106 HYDE LANE, STATESVILLE NC 28625

LOCATION NC 115 N, TL PISGAH ROAD, TL TREE BARK RD, TR HIDDEN RIVER LN, AT END ON LEFT

SUBDIVISION HIDDEN RIVER BLOCK / SECTION ____ LOT 13 LOT AREA 14.95 ACRES SITE CLASS PS DESIGN FLOW 480 L.T.A.R. 0.30 GPD/FT²

Septic Tank: 1000 Gallons; STB 1007 Date 6-24-02
Pump Tank: ____ Gallons; PT ____ Date ____
Pump Make: ____ Model ____ Serial No ____
Nitrification Field: No Fields 1 Square Feet 1600 Linear Feet 533
No Lines FOUR Trench Width 36" Max Trench Bottom Depth 36" Gravel Depth 12"

☑ New System ☐ Repair System Type: I II III IV V VI
System Description: CONVENTIONAL GRAVITY
Repair System Description: CONVENTIONAL GRAVITY
Maintenance Agreement Required: ☐ Yes ☑ No
☐ Slab ☑ Crawl Space ☐ Basement w/plumbing ☐ Basement wo/plumbing


☑ House/Mod. Home No. Bedrooms 4
☐ Mobile Home No. Bathrooms 3
☐ Business No. Employees ____
☐ Other ____

Water Supply:
☑ Individual
☐ Public
☐ Community
WELL

Comments/Conditions: KEEP SYSTEM MINIMUM 100 FEET FROM WELL

Comments/Conditions: SEPTIC TANK WITH MARKER INSTALLED USING "POLY LOK" FILTER

INITIAL SITE SKETCH ~ SCALE: 1"=50'

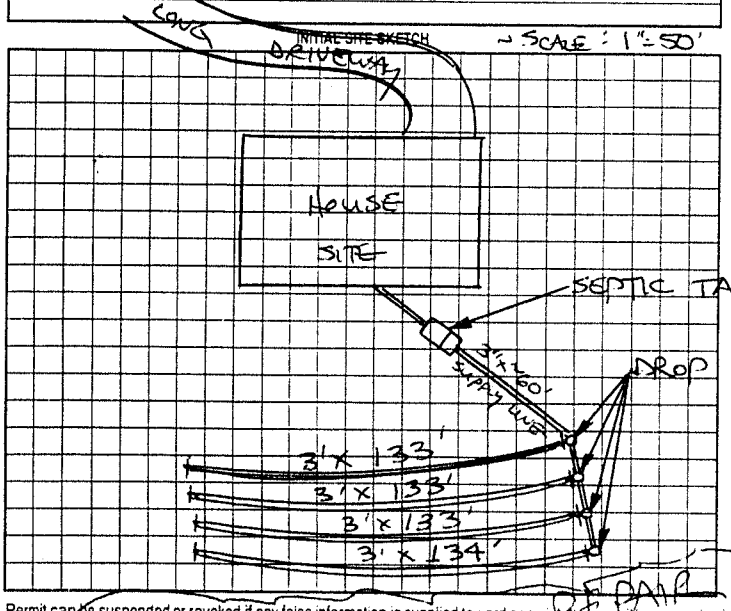

AS BUILT SKETCH

SYSTEM INSTALLED ACCORDING TO INITAL SITE SKETCH

Permit can be suspended or revoked if any false information is supplied toward securing this permit, any unauthorized changes are made to the site, any unauthorized changes are made in the installation of the system. Improvement Permit with plat valid without expiration. Improvement Permit with site plan valid for sixty months. Authorization to Construct is valid for a period equal to that of Improvement Permit – not to exceed sixty months

Signed: James Henderson date 7-25-02 Installed by: SCOTT GREENE

Improvement Permit by: STEVE HEDRICK date 7-19-02 Operation Permit by: STEVE HEDRICK date 8-22-02

Authorization to Construct by: STEVE HEDRICK date 7-19-02 Existing System Inspection by: ____ date ____

HEALTH DEPT COPY: WHITE OWNER COPY (FINAL): YELLOW OWNER COPY (INITIAL): PINK