Melvern Spaulding
150 Hidden River Ln.
Permit # 178184

Location of the proposed 22'x16' Detached Garage addition does not appear to impact the existing on-site septic system.**NOTE:
Justin Henderson REHS
Date: 4-18-13
ICHD-Environmental Health Division

IREDELL COUNTY HEALTH DEPARTMENT
STATESVILLE 704-878-5305 ✓ MOORESVILLE 704-664-5281
IMPROVEMENT PERMIT / AUTHORIZATION TO CONSTRUCT / OPERATION PERMIT / EXISTING SYSTEM INSPECTION

DATE 5/3/01

PERMIT# 094359 PIN# 4728021834 PHONE: Business (704) 871-1536 Home —
OWNER OR CONTRACTOR Crandall F. O'Brien
ADDRESS 370 Treelark Lane Statesville NC 28625
LOCATION Hwy 115 N, (L) Rigsan, (L) Treelark on Left
SUBDIVISION Hidden River BLOCK / SECTION — LOT 6 LOT AREA 2.02 SITE CLASS PS DESIGN FLOW 360 L.T.A.R. -30

Septic Tank: 1000 Gallons: STB 1012 Date 3-27-01
Pump Tank: — Gallons: PT — Date —
Pump Make: — Model — Serial No. —
Nitrification Field: No. Fields 1 Square Feet 1200 Linear Feet 400
No Lines 5 @ 80' Trench Width 36" Max Trench Bottom Depth 36" Gravel Depth 12"

X New System ☐ Repair System Type: I (II) III IV V VI
System Description: Gravity Conv.
Repair System Description: Pump, 50% Reduction
Maintenance Agreement Required: ☐ Yes X No


X House/Mod. Home ☐ Mobile Home ☐ Business ☐ Other
No. Bedrooms 3 No. Bathrooms 2 No. Employees —
X Slab X Crawl Space ☐ Basement w/plumbing ☐ Basement w/o plumbing

Water Supply: X Individual ☐ Public ☐ Community


Comments/Conditions: (1) Install Bed on Contour (2) Do not install Interlock (3) Keep well 100± from System

Comments/Conditions:

INITIAL SITE SKETCH

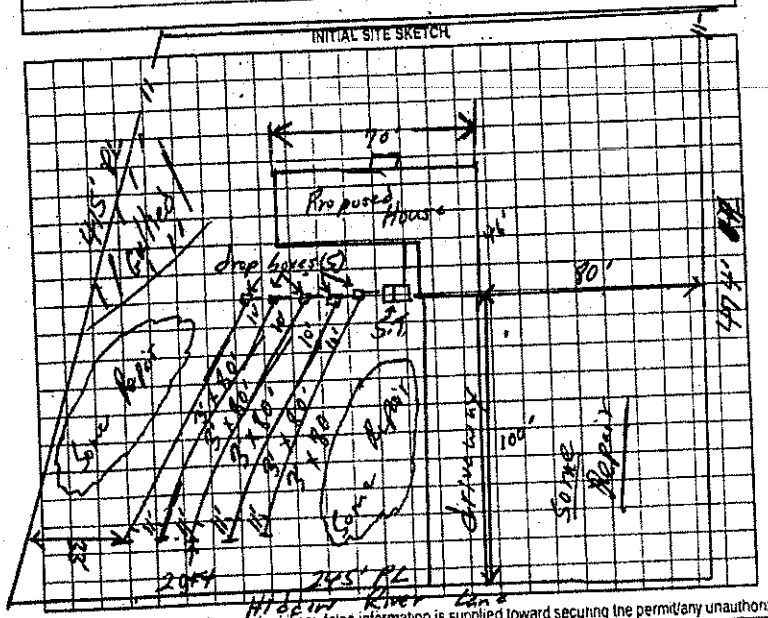

AS BUILT SKETCH

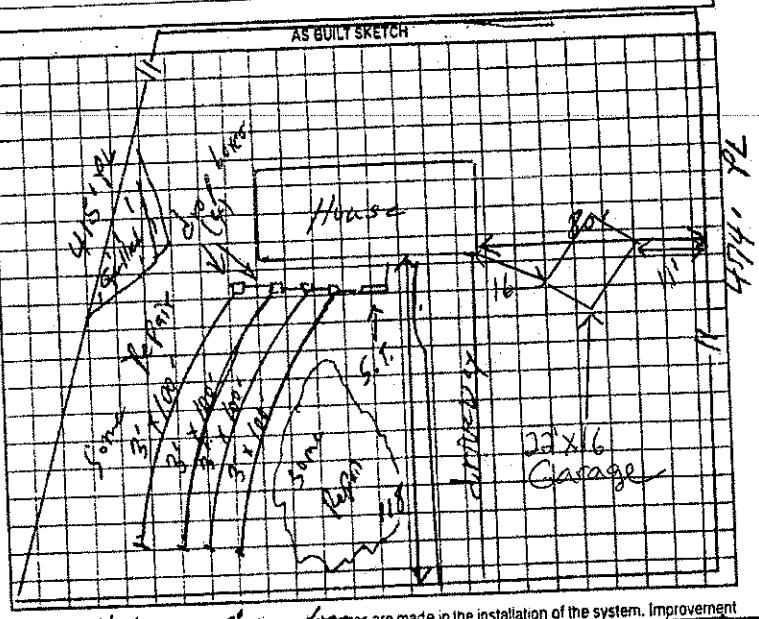

Permit can be suspended or revoked if any false information is supplied toward securing the permit/any unauthorized changes are made to the site and/or unauthorized changes are made in the installation of the system. Improvement Permit with plat valid without expiration. Improvement Permit with site plan valid for sixty months. Authorization to Construct is valid for a period equal to that of Improvement Permit – not to exceed sixty months.

Signed: [signature] date 5-11-01
Improvement Permit by: [signature] RST date 5/3/01
Authorization to Construct by: [signature] RST date 5/3/01

Installed by: A-1 Backhoe
Operation Permit by: [signature] date 11/7/01
Existing System Inspection by: — date —

HEALTH DEPT COPY WHITE OWNER COPY (FINAL) YELLOW OWNER COPY (INITIAL) PINK