IREDELL COUNTY HEALTH DEPARTMENT - *ENVIRONMENTAL HEALTH* ☑ STATESVILLE OFFICE 704-878-5305 ☐ MOORESVILLE OFFICE 704-664-5281

IMPROVEMENT PERMIT / AUTHORIZATION TO CONSTRUCT / OPERATION PERMIT / EXISTING SYSTEM INSPECTION

PERMIT # 165116 PIN # 4719-01-9750 DATE 23 February 2011

OWNER Kelly Pierce APPLICANT: PHONE: Home/Cell# (704) 500-9267 Business #

SITE ADDRESS 246 Hill Farm Rd - Hiddenite OWNER / APPLICANT ADDRESS 408 Bank St. Statesville

SITE DIRECTIONS 115N TL Pisgah Ch. Rd. TR Bowles Farm Rd. TL Hill Farm Rd. ON RT.

SUBDIVISION Day B. Levan BLOCK / SECTION LOT # TR-1 LOT AREA 5Ac DESIGN FLOW 360gpd L.T.A.R. 0.3 g/ft²/d

Septic Tank 1000g Gallons: STB 160 Date 10-21-10

Pump Tank Gallons: P T Date

Pump Make Model Serial #

No. Nitrification Fields: 1 No. Lines 3 Linear Feet 300

Trench Width 36" Max. Trench Bottom Depth 36" Gravel Depth N/A

☑ New System ☐ Repair ☐ Expansion System Type I II (III) IV V VI

System Description: 25% Reduction System

Repair System Description: 25% Reduction System.

Maintenance Agreement Required ☐ YES ☑ NO

☑ GRAVITY ☐ PRESSURE

☑ Residence No. Bedrooms 3

☐ Business No. Persons

☐ Other No. Employees

☐ Slab ☑ Crawl Space


☐ Basement w/plumbing ☐ Basement w/o plumbing

Water Supply: ☑ Private Ex. SY. ☐ Public ☐ Community


Comments / Conditions

Lot - tight for tee

INITIAL SITE SKETCH

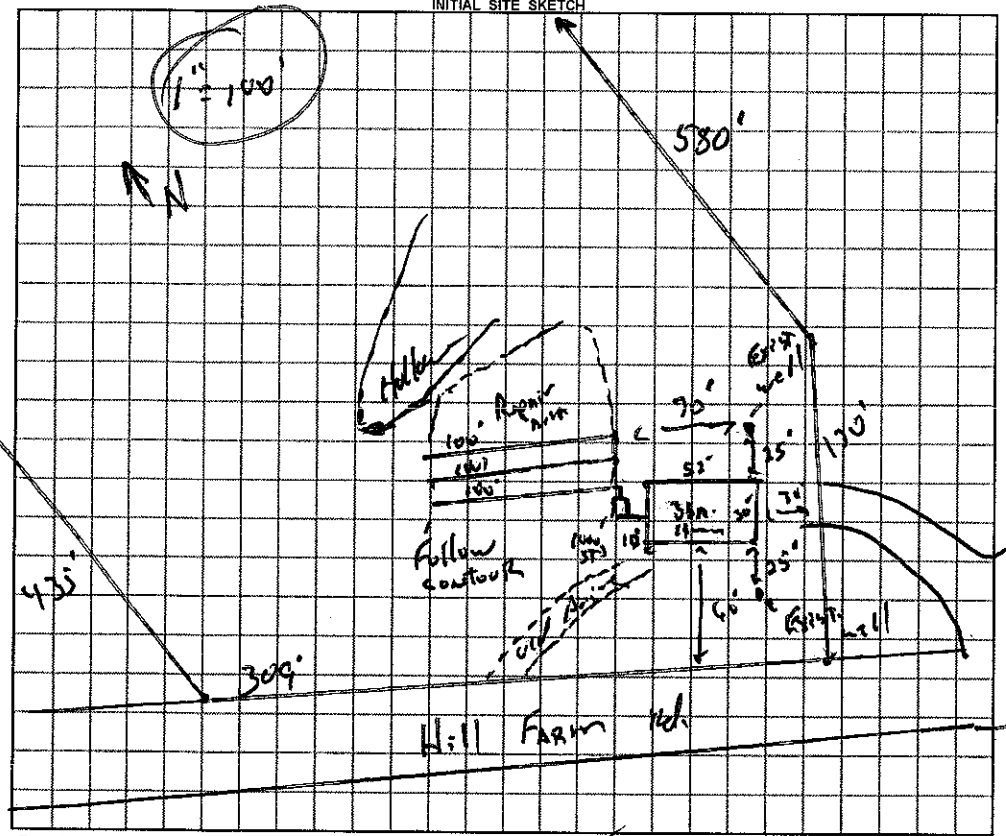

AS BUILT SKETCH

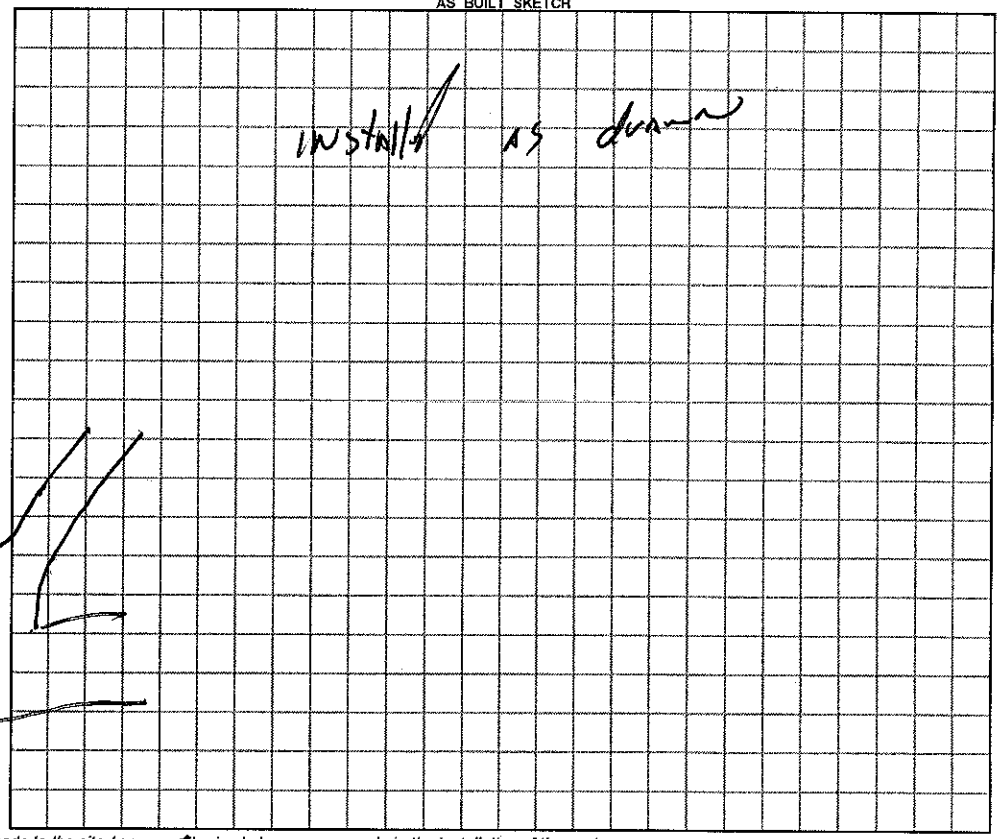

Permit can be suspended or revoked if any false information is supplied toward securing the permit / any unauthorized changes are made to the site / any unauthorized changes are made in the installation of the system.

☐ *IMPROVEMENT PERMIT with plat valid without expiration.* ☑ *IMPROVEMENT PERMIT with plat valid ~~without expiration~~* ☑ *AUTHORIZATION TO CONSTRUCT* valid for period equal to IMPROVEMENT PERMIT--not to exceed 60 mo.

Owner / Applicant Signature: Date 2-24-11 (60 mos.) Installed by: Kevin Bowles

IMPROVEMENT PERMIT by: REHS Date 23 Feb. 11 OPERATION PERMIT by: REHS Date 3-23-11

AUTHORIZATION TO CONSTRUCT by: REHS Date 23 Feb. 11 Existing System Inspected by: REHS Date

YOU SHOULD CONTACT A LOCATOR SERVICE PRIOR TO ANY EXCAVATION

White Copy -- Environmental Health YELLOW COPY (Final) Owner / Applicant PINK COPY (Initial) Owner / Applicant