IREDELL COUNTY HEALTH DEPARTMENT

THIS PERMIT VOIDS PREVIOUS ISSUED 9-2-98

STATESVILLE 704-878-5305 MOORESVILLE 704-664-5281

IMPROVEMENT PERMIT / AUTHORIZATION TO CONSTRUCT / OPERATION PERMIT / EXISTING SYSTEM INSPECTION

PERMIT# 070344 PIN# 4709 98 2284 DATE 8-3-99

OWNER OR CONTRACTOR RANDALL L. PADGETT PHONE: Business Home 539-5239

ADDRESS P.O. BOX 113, UNION GROVE, NC 28689

LOCATION NC 115 N, TL PISGAH, TR HILL FARM, TL PISGAH RIDGE, REAR LEFT, 0.3 MILE ON LEFT, 0.4 MI BACK

SUBDIVISION BLOCK / SECTION LOT LOT AREA ~10 ACRES SITE CLASS PS DESIGN FLOW 360 L.T.A.R. 0.33 GPD/FT²

Septic Tank: 1000 Gallons; STB 1012 Date 7-6-99
Pump Tank: Gallons; PT Date
Pump Make: Model Serial No.
Nitrification Field: No Fields 1 Square Feet 1080 Linear Feet 360
No Lines THREE Trench Width 36" Max Trench Bottom Depth 36" Gravel Depth 12"

✓ New System ☐ Repair System Type: I, ☑ II, III, IV, V, VI
System Description: CONVENTIONAL GRAVITY
Repair System Description:
Maintenance Agreement Required: ☐ Yes ☐ No ✓
☐ Slab ✓ Crawl Space ☐ Basement w/plumbing ☐ Basement wo/plumbing

☐ House/Mod. Home No. Bedrooms 3
☐ Mobile Home No. Bathrooms 2
☐ Business No. Employees
☐ Other


Water Supply: ~~Individual~~ ☐ Public ☐ Community WELL

Comments/Conditions: KEEP WELL MINIMUM 100 FEET FROM SYSTEM

Comments/Conditions:

SCALE: 1" = 40'

INITIAL ~~SITE~~ SKETCH

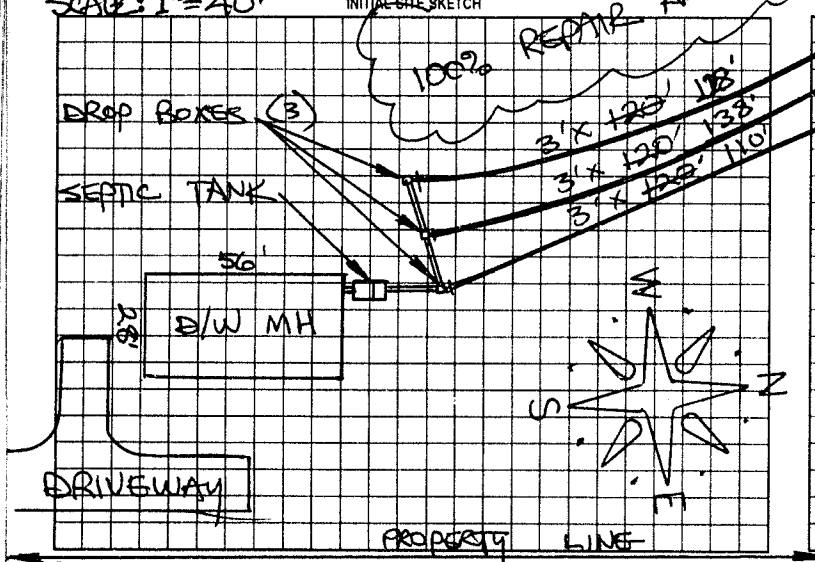

AS BUILT SKETCH

SYSTEM INSTALLED AS SHOWN

Permit can be suspended or revoked if any false information is supplied toward securing the permit/any unauthorized changes are made to the site/any unauthorized changes are made in the installation of the system. Improvement Permit with plat valid without expiration. Improvement Permit with site plan valid for sixty months. Authorization to Construct is valid for a period equal to that of Improvement Permit – not to exceed sixty months.

Signed: [signature] date 8-3-99 Installed by: A-1 BACKHOE

Improvement Permit by: STEVE HEDRICK date 8-3-99 Operation Permit by: STEVE HEDRICK date 9-13-99

Authorization to Construct by: STEVE HEDRICK date 8-3-99 Existing System Inspection by: date

HEALTH DEPT COPY WHITE OWNER COPY (FINAL) YELLOW OWNER COPY (INITIAL) PINK