IREDELL COUNTY HEALTH DEPARTMENT - *ENVIRONMENTAL HEALTH* ☑ STATESVILLE OFFICE 704-878-5305 ☐ MOORESVILLE OFFICE 704-664-5281

IMPROVEMENT PERMIT / AUTHORIZATION TO CONSTRUCT / OPERATION PERMIT / EXISTING SYSTEM INSPECTION

PERMIT # 164759 PIN # 4719-11-2725 DATE 22 February 2011

OWNER David + Shannon Miller APPLICANT: PHONE: Home/Cell # (704) 883-4490 Business #

SITE ADDRESS 244 Hill Farm Rd. Hiddenite OWNER / APPLICANT ADDRESS

SITE DIRECTIONS 115N TL Pisgah Ch. Rd. TR Bowles Farm Rd. TL Hill Farm Rd - Prop. on Rt.

SUBDIVISION BLOCK / SECTION LOT # LOT AREA 5.14ac. DESIGN FLOW 480g/d L.T.A.R. 0.3g/ft²/d

Septic Tank 1000 Gallons: STB 760 Date 2-08/10 ☑ New System ☐ Repair ☐ Expansion System Type I II III IV V VI

Pump Tank Gallons: P T Date System Description: 25% Reduction System

Pump Make Model Serial # Repair System Description: 25% Reduction System

No. Nitrification Fields: 1 No. Lines 4 Linear Feet 400 Maintenance Agreement Required ☐ YES ☑ NO

Trench Width 36" Max. Trench Bottom Depth 36" Gravel Depth N/A ☑ GRAVITY ☐ PRESSURE

☑ Residence No. Bedrooms 4 Water Supply

☐ Business No. Persons ☑ Private


☐ Other No. Employees ☐ Public

☐ Slab ☑ Crawl Space ☐ Community


☐ Basement w/plumbing ☐ Basement w/o plumbing

Comments / Conditions * Keep out of hands/spa.

INITIAL SITE SKETCH

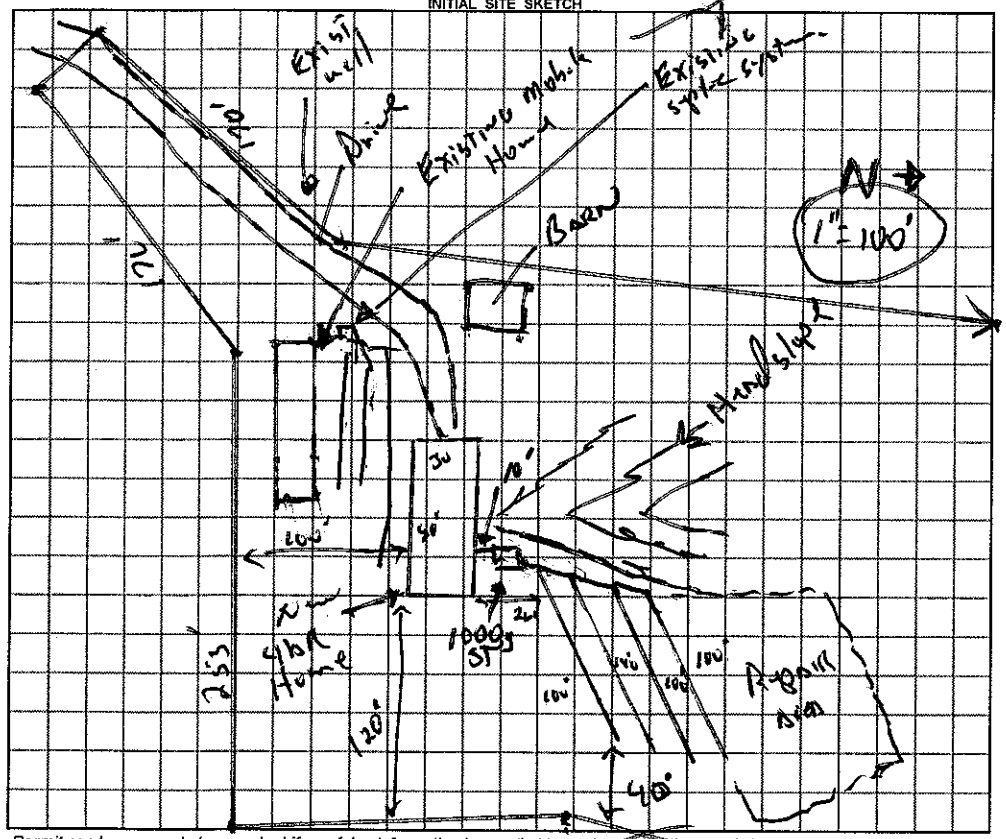

AS BUILT SKETCH

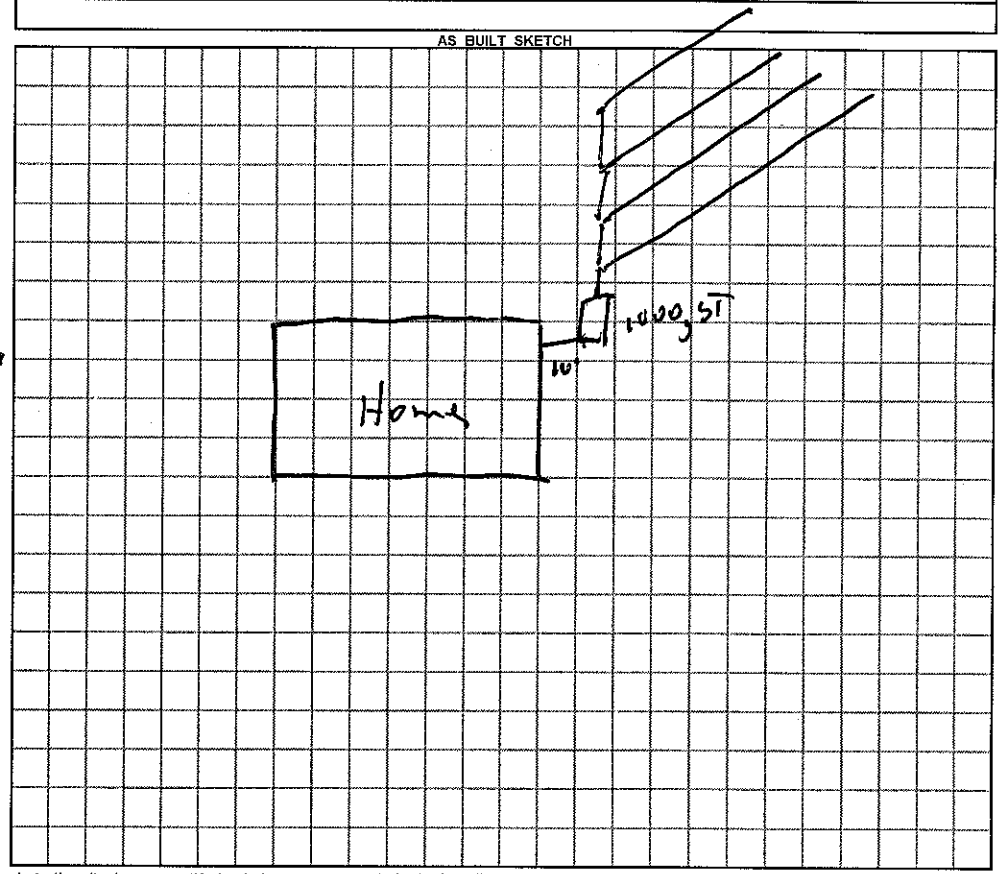

Permit can be suspended or revoked if any false information is supplied toward securing the permit / any unauthorized changes are made to the site / any unauthorized changes are made in the installation of the system.

☐ ***IMPROVEMENT PERMIT*** *with plat valid without expiration.* ☑ ***IMPROVEMENT PERMIT*** *with plat valid ~~without expiration~~* 60mos. ☑ ***AUTHORIZATION TO CONSTRUCT*** valid for period equal to IMPROVEMENT PERMIT--not to exceed 60 mo.

Owner / Applicant Signature: W C Miller Date 2-27 Installed by: A-1 Backhoe

IMPROVEMENT PERMIT by: REHS Date 22 Feb. 11 OPERATION PERMIT by: REHS Date 6 June 11

AUTHORIZATION TO CONSTRUCT by: REHS Date 22 Feb. 11 Existing System Inspected by: REHS Date

YOU SHOULD CONTACT A LOCATOR SERVICE PRIOR TO ANY EXCAVATION

White Copy -- Environmental Health YELLOW COPY (Final) Owner / Applicant PINK COPY (Initial) Owner / Applicant