IREDELL COUNTY HEALTH DEPARTMENT

STATESVILLE 704-878-5305 MOORESVILLE 704-664-5281

IMPROVEMENT PERMIT / AUTHORIZATION TO CONSTRUCT / OPERATION PERMIT / EXISTING SYSTEM INSPECTION

PERMIT # 163328 PIN # 4719 25 1997 DATE Sept 24, 2010

OWNER or APPLICANT Rance Moore PHONE: Business Home:

OWNER or APPLICANT ADDRESS 607 Pisgah Ridge Circle, Hiddenite, NC

LOCATION / DIRECTIONS From Statesville, 115 N, TL Damascus Ch. Rd. TL Laurel Oak Rd. TL @ Stop Sign onto Pisgah Ridge Circle - house on left

SUBDIVISION BLOCK / SECTION LOT # LOT AREA ~20 Ac DESIGN FLOW L.T.A.R.

Septic Tank Existing Gallons: STB Date
Pump Tank Gallons: P T Date
Pump Make Model Serial #
Nitrification Field No Fields Ex No Lines Linear Feet
Trench Width Max. Trench Bottom Depth Gravel Depth

☐ New System ☐ Repair ☐ Expansion System Type I II III IV V VI
System Description:
Repair System Description:
Maintenance Agreement Required ☐ YES ☐ NO
☑ GRAVITY ☐ PRESSURE


☐ Residence No. Bedrooms Ex
☐ Business No. Persons
☐ Other No. Employees
☐ Slab ☐ Crawl Space
☐ Basement w/plumbing ☐ Basement w/o plumbing

Water Supply
☑ Private
☐ Public
☐ Community


Comments / Conditions No record of septic system found. This system appears to predate sewage rules. Information on drainfield location based on information from current + previous owner. No sign of sewage malfunction observed. Office addition does NOT require increase in sewage flow; No additional people in home.

Comments / Conditions

INITIAL SITE SKETCH

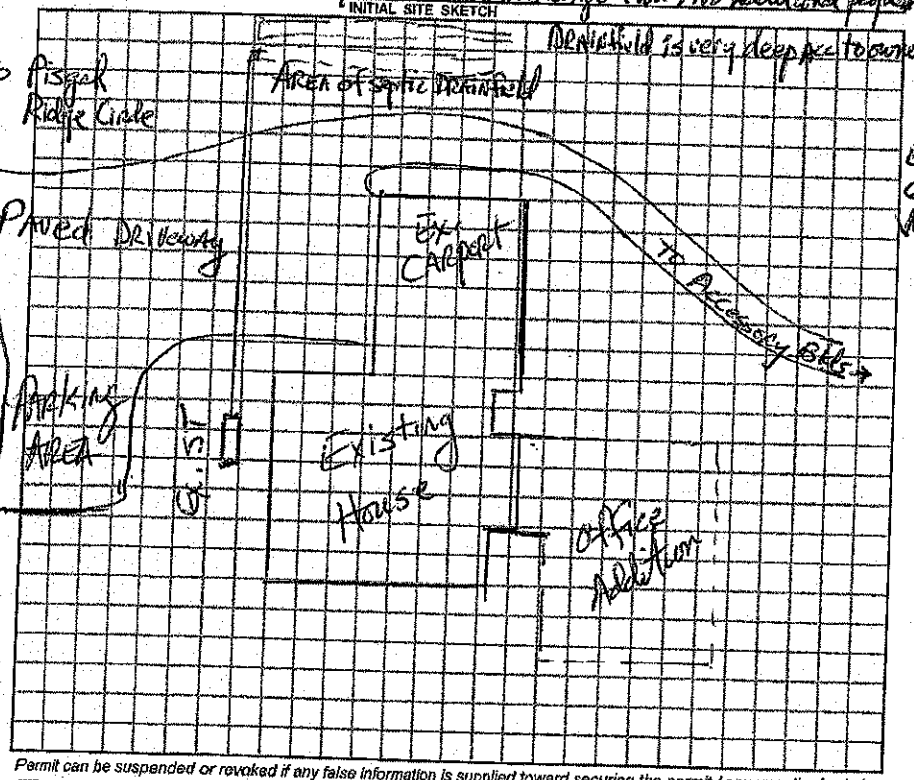

AS BUILT SKETCH

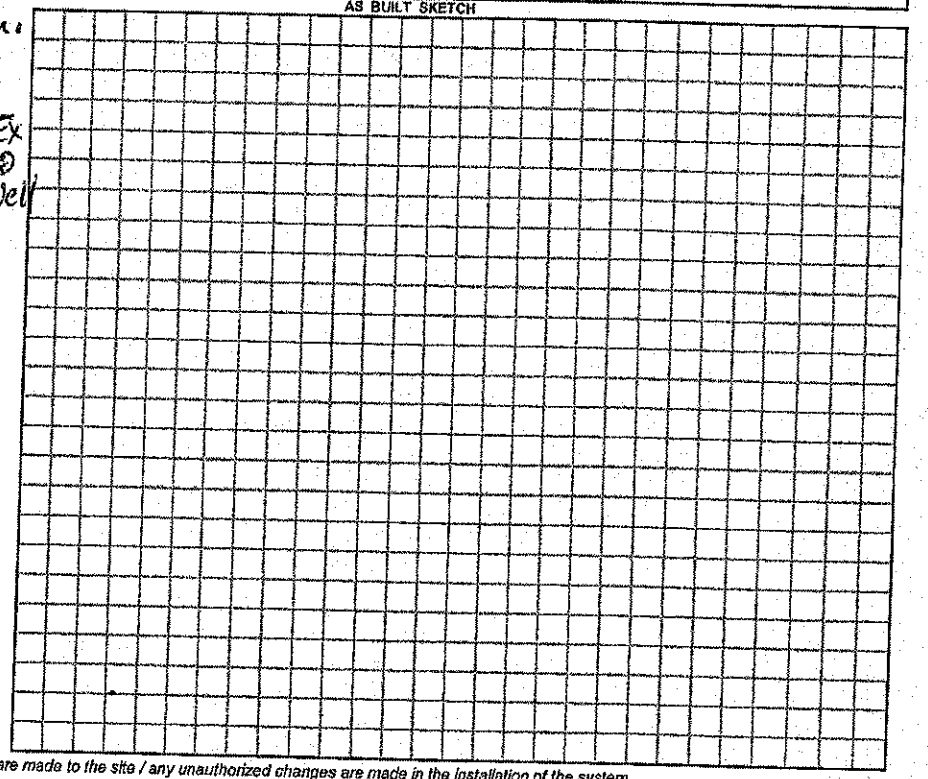

Permit can be suspended or revoked if any false information is supplied toward securing the permit / any unauthorized changes are made to the site / any unauthorized changes are made in the installation of the system.

☐ IMPROVEMENT PERMIT w / plat valid without expiration. ☐ IMPROVEMENT PERMIT w / site plan valid for 60 mos. ☐ AUTHORIZATION TO CONSTRUCT valid for period equal to IMPROVEMENT PERMIT-not to exceed 60 mo.

Owner / Applicant Signature: Date Sept 24/10

Improvement Permit by: Date

Authorization to Construct by: Date

YOU SHOULD CONTACT A LOCATOR SERVICE PRIOR TO ANY EXCAVATION.

Installed by:

Operation Permit by: Date:

Existing System Inspected by: DHHuss, REHS Date: Sept 24, 10

WHITE COPY Environmental Health YELLOW COPY (Final) Owner / Applicant PINK COPY (Initial) Owner / Applicant