IREDELL COUNTY HEALTH DEPARTMENT

Statesville Office (704) 878-5305 Mooresville Office (704) 660-3625 PERMIT # 209756

IMPROVEMENT PERMIT / AUTHORIZATION TO CONSTRUCT / OPERATION PERMIT / EXISTING SYSTEM

PIN # 4719253914

APPLICANT: J.C. Moose APPLICANT ADDRESS: 1227 Troutman Dr. Statesville

SITE ADDRESS: 607 Pisgah Ridge Circle PHONE: 704-873-2171 ALT. PHONE: N/A


SITE DIRECTIONS: 115N TL Pisgah Church Rd TR Hill Farm Rd TL Pisgah Ridge Circle

SUBDIVISION: N/A SECTION: N/A LOT # N/A LOT AREA: 8.776 acres DESIGN FLOW: Existing L.T.A.R.: Existing


Septic Tank	1000	(gal)	STB	760 - 1000	Date	3-7-1	☐ New System	☑ Repair	☐ Expansion	System Type: I (II) III IV V VI	☑ Residence	No. Bedrooms	6x	Water Supply	
Pump Tank		(gal)	PT		Date		System Description:				☐ Business	No. Persons	6x	☑ Private	
Pump Make		Model			Serial #		Repair System Description:	TANK			☐ Other	No. Employees		☐ Public	
# Nitrification Fields	6x	# Lines	6x		Linear Ft:	6x	Maintenance Agreement Required:	☐ YES	☑ NO		☐ Slab	☑ Crawl Space		☐ Community	
Trench Width	6x	Max. Trench Bottom Depth	6x		Gravel Depth	6x		☑ GRAVITY	☐ PRESSURE		☐ Basement w/ plumbing		☐ Basement w/o plumbing		

Comments / Conditions: Pump & crush existing septic tank. Install new septic tank @ location shown below & connect to existing drainfield.

INITIAL SITE SKETCH

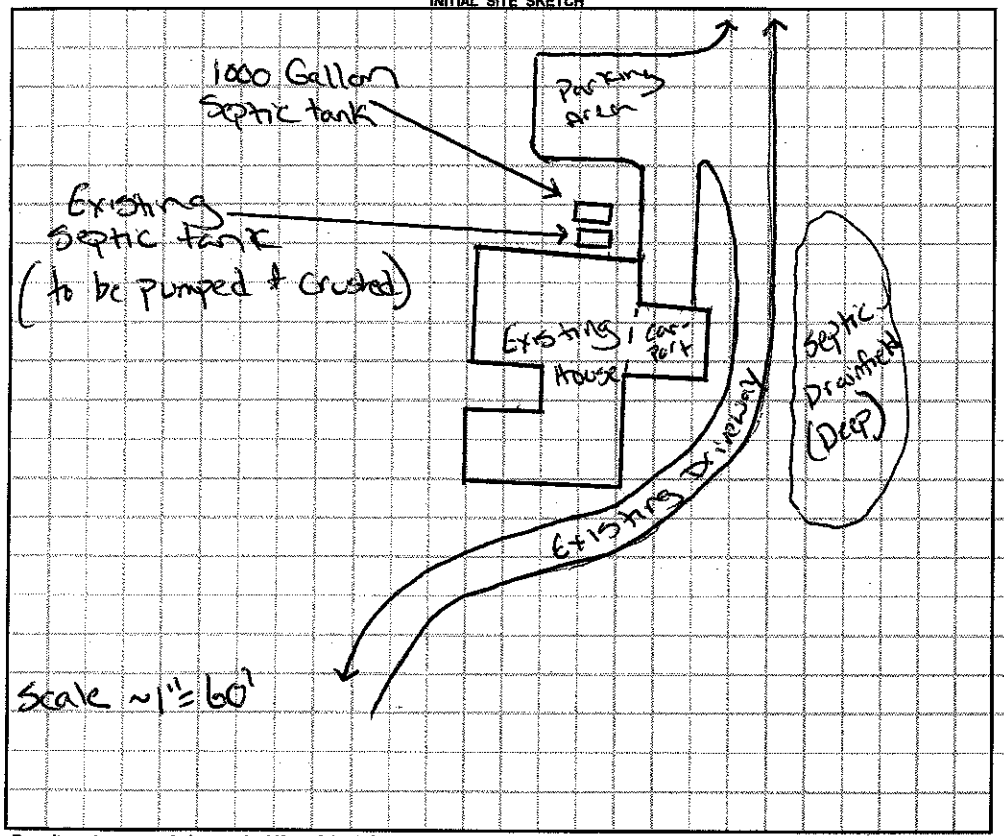

AS BUILT SKETCH

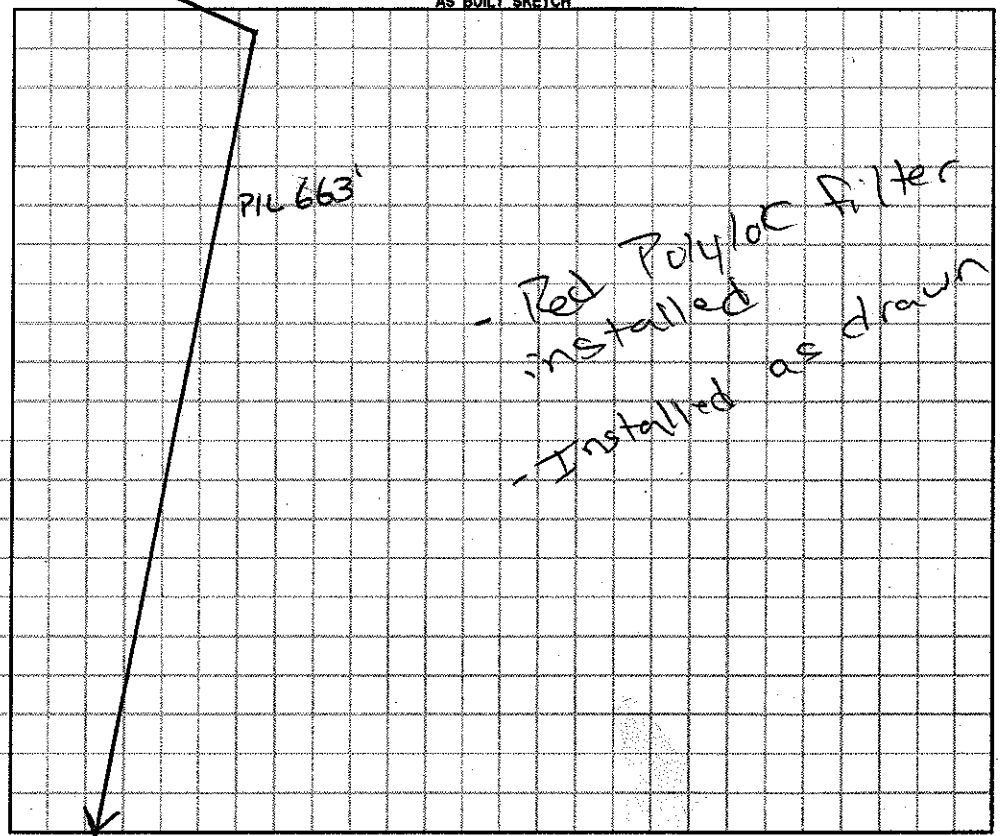

Permit can be suspended or revoked if any false information is supplied toward securing the permit / any unauthorized changes are made to the site / any unauthorized changes are made in the installation of the system. **CONTACT A LOCATOR SERVICE PRIOR TO ANY EXCAVATION**

☐ **IMPROVEMENT PERMIT** *with plat valid without expiration.* ☑ **IMPROVEMENT PERMIT** *with site plan valid for 60 mos.* ☑ **AUTHORIZATION TO CONSTRUCT** *valid for period equal to IMPROVEMENT PERMIT--not to exceed 60 mo.*

Owner / Applicant Signature: Renee moore by J. moore Date: 5-29-15 Installed by: Lentz

IMPROVEMENT PERMIT by: Justin Henderson Date: 4-24-15 OPERATION PERMIT by: Justin Henderson Date: 7-8-15

AUTHORIZATION TO CONSTRUCT by: Justin Henderson Date: 4-24-15 Existing System Inspected by: Date:

Health Dept. Copy - WHITE Applicant (Final Approval) - YELLOW Applicant (Conditional Approval) - PINK