IREDELL COUNTY HEALTH DEPARTMENT

Statesville Office (704) 878-5305 Mooresville Office (704) 660-3625 PERMIT # 209892

IMPROVEMENT PERMIT / AUTHORIZATION TO CONSTRUCT / OPERATION PERMIT / EXISTING SYSTEM

PIN # 4719-25-3914.000

APPLICANT: J.C. Moore APPLICANT ADDRESS: 1227 Troutman Dr. Statesville NC

SITE ADDRESS: 605 Pisgah Ridge Cir. Hiddenite, NC PHONE: 704-873-2171 ALT. PHONE: 910-833-7049


SITE DIRECTIONS: NC 115 N, TR Pisgah Ch. Rd., TR Hill Farm Rd., TR Pisgah Ridge Cir., R at Fork, Site on R

SUBDIVISION: — SECTION: — LOT # — LOT AREA: 8.776 Acre DESIGN FLOW: 240 GPD. L.T.A.R.: .3


Septic Tank Existing (gal)	STB	Date	☐ New System ☐ Repair ☒ Expansion System Type: I II III IV V VI	☒ Residence	No. Bedrooms 2	Water Supply
Pump Tank (gal)	PT	Date	System Description: 25% Reduction - Gravity	☐ Business	No. Persons 4	☒ Private
Pump Make	Model	Serial #	Repair System Description: Drip Irrigation	☐ Other	No. Employees	☐ Public
# Nitrification Fields 1	# Lines 3 @ 67'	Linear Ft: 200'	Maintenance Agreement Required: ☐ YES ☒ NO	☒ Slab	☒ Crawl Space	☐ Community
Trench Width 36"	Max. Trench Bottom Depth 24" *	Gravel Depth N/A	☒ GRAVITY ☐ PRESSURE	☐ Basement w/plumbing	☐ Basement w/o plumbing	

Comments / Conditions: Disconnect Existing 100' Conventional Line. Leave As Possible Repair. (Not on Contour.) Install New 200' of 25% Reduction By Hooked Into Existing D-Box. Install New Filtered Tee If One Is Not Present. Follow All Septic Rules.

INITIAL SITE SKETCH

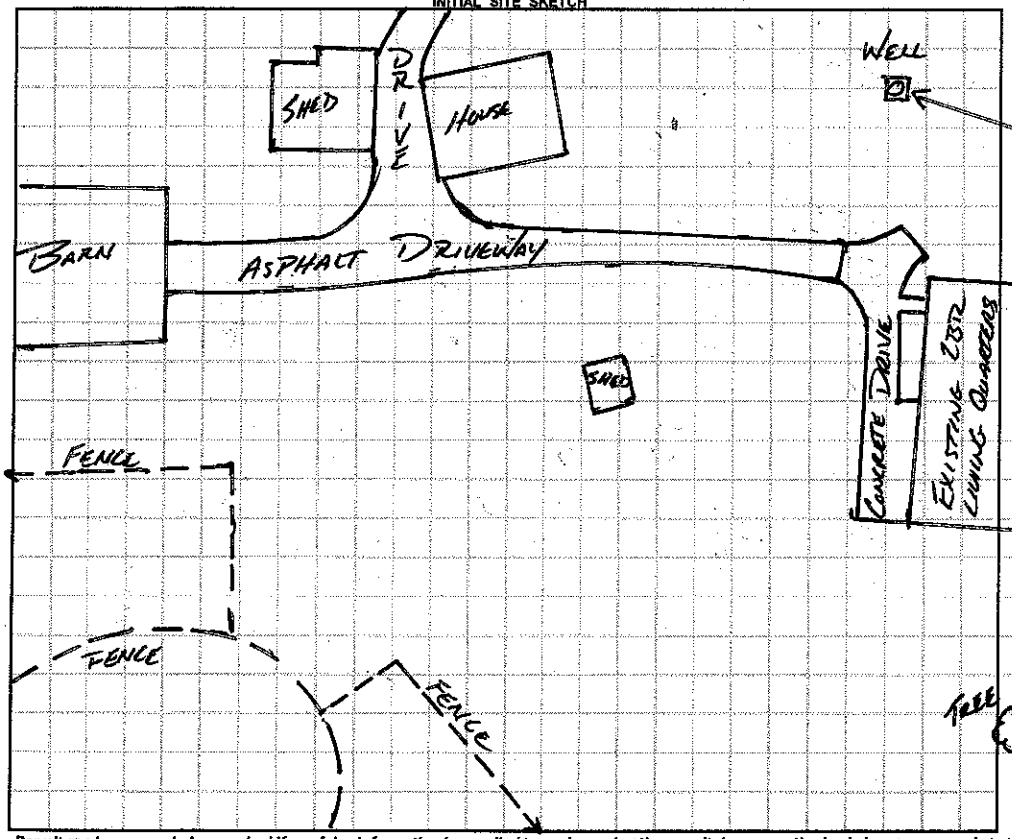

AS BUILT SKETCH

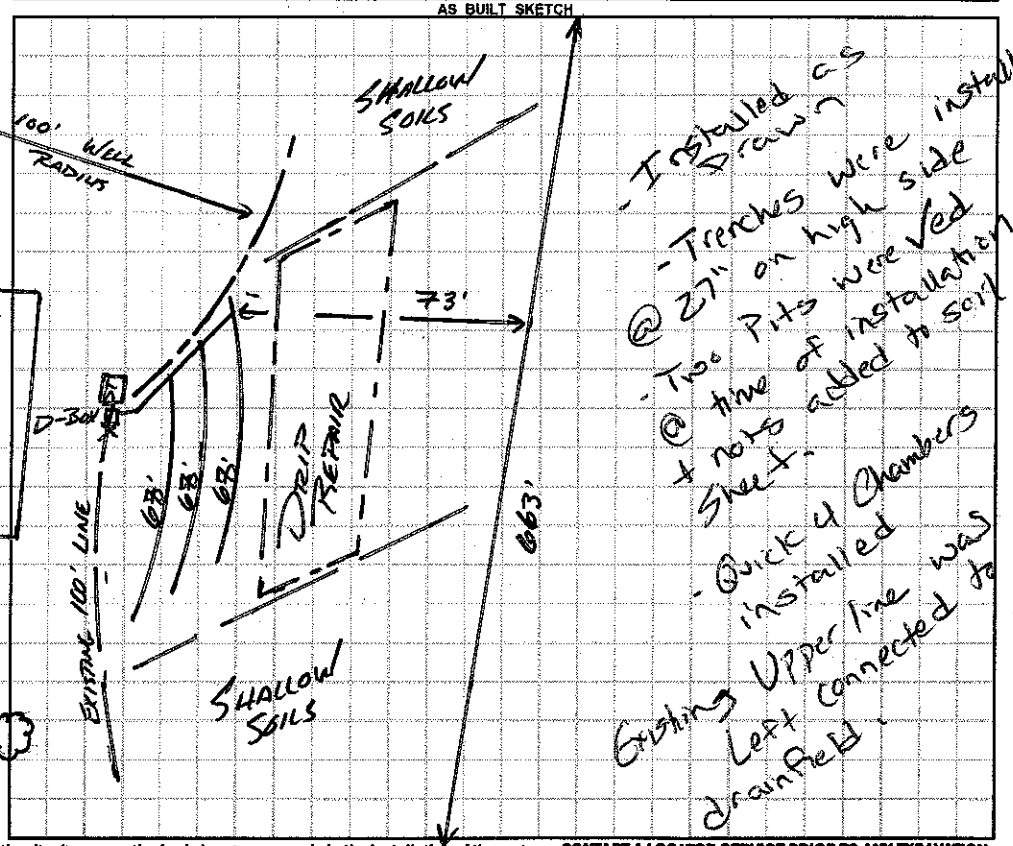

Permit can be suspended or revoked if any false information is supplied toward securing the permit / any unauthorized changes are made to the site / any unauthorized changes are made in the installation of the system. **CONTACT A LOCATOR SERVICE PRIOR TO ANY EXCAVATION**

☐ **IMPROVEMENT PERMIT** *with plat valid without expiration.* ☒ **IMPROVEMENT PERMIT** *with site plan valid for 60 mos.* ☒ **AUTHORIZATION TO CONSTRUCT** *valid for period equal to IMPROVEMENT PERMIT--not to exceed 60 mo.*

Owner / Applicant Signature: Rememoore By J.C.moore Date: 5-29-15 Installed by: Lentz Septic

IMPROVEMENT PERMIT by: APPROVED Date: MAY 26 2015 OPERATION PERMIT by: Justin Henderson Date: 7-9-15

AUTHORIZATION TO CONSTRUCT by: APPROVED Date: MAY 27 2015 Existing System Inspected by: Date:

Health Dept. Copy - WHITE Applicant (Final Approval) - YELLOW Applicant (Conditional Approval) - PINK