IREDELL COUNTY HEALTH DEPARTMENT

STATESVILLE 704-878-5305 MOORESVILLE 704-664-5281

IMPROVEMENT PERMIT / AUTHORIZATION TO CONSTRUCT / OPERATION PERMIT / EXISTING SYSTEM INSPECTION

PERMIT # 158472 PIN # 4719-27-0837 DATE 13 October 09

OWNER or APPLICANT Todd Dishman PHONE: Business (704) 437-9807 Home:

OWNER or APPLICANT ADDRESS 133 Dishman Ridge Lane Hiddenite, NC.

LOCATION / DIRECTIONS Hwy 115 N TL Pisgah TR Pisgah Ch Rd. TR Hill From TR Pisgah Ridge Circle Turn R Dishman Rdge.

SUBDIVISION BLOCK / SECTION LOT # LOT AREA DESIGN FLOW L.T.A.R.

Septic Tank 1000 Gallons: STB 1007 Date 9-22-09

Pump Tank Gallons: P T Date

Pump Make Model Serial #

Nitrification Field No Fields No Lines Linear Feet

Trench Width Max. Trench Bottom Depth Gravel Depth

☑ New System ☐ Repair ☐ Expansion System Type I II III IV V VI

System Description: Tank Replacement

Repair System Description: 25% Reduction

Maintenance Agreement Required ☐ YES ☑ NO

☑ GRAVITY ☐ PRESSURE

☑ Residence No. Bedrooms 3

☐ Business No. Persons

☐ Other No. Employees

☐ Slab ☑ Crawl Space


☐ Basement w/plumbing ☐ Basement w/o plumbing

Water Supply: ☑ Private ☐ Public ☐ Community

Comments / Conditions * Replace Septic Tank 15' from existing pool / Abandon existing septic tank / Replace D-box AND cut-off lines that are within 15' of pool.

Comments / Conditions

INITIAL SITE SKETCH

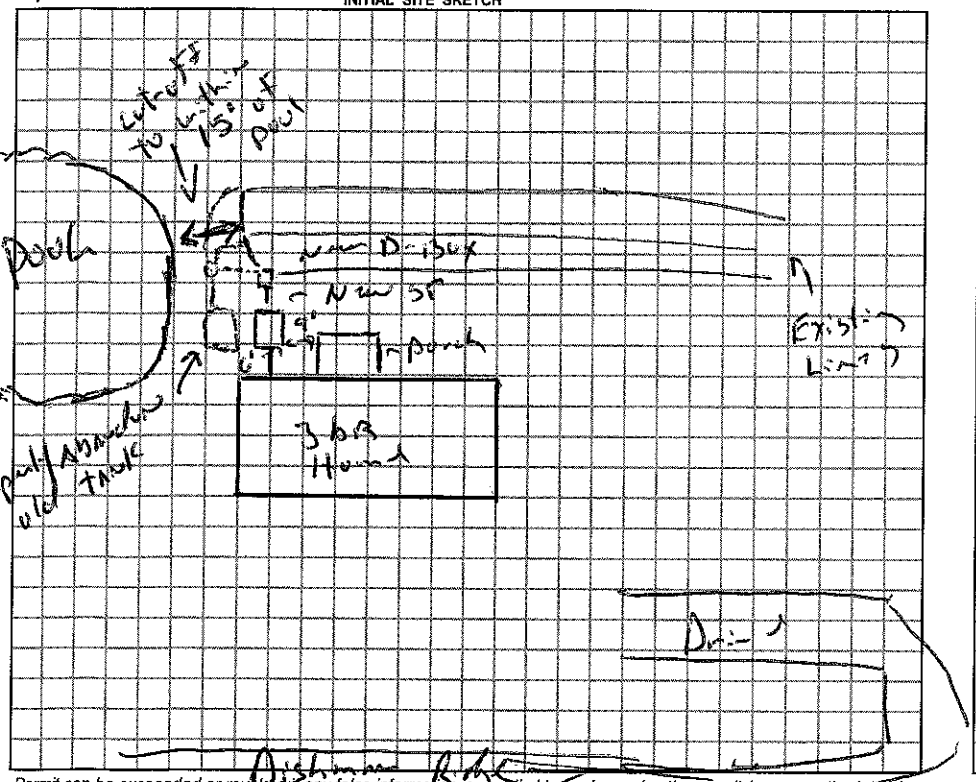

AS BUILT SKETCH

Permit can be suspended or revoked if any false information is supplied toward securing the permit / any unauthorized changes are made to the site / any unauthorized changes are made in the installation of the system.

☐ IMPROVEMENT PERMIT w / plat valid without expiration ☑ IMPROVEMENT PERMIT w / site plan valid for 60 mos. ☑ AUTHORIZATION TO CONSTRUCT valid for period equal to IMPROVEMENT PERMIT-not to exceed 60 mo.

Owner / Applicant Signature: Todd Dishman Date 10-13-09

Improvement Permit by: [signature], R.S. Date 13 Oct. 09

Authorization to Construct by: [signature], R.S. Date 13 Oct. 09

Installed by: Kelly Welborn

Operation Permit by: [signature] Date: 11-9-09

Existing System Inspected by: Date:

YOU SHOULD CONTACT A LOCATOR SERVICE PRIOR TO ANY EXCAVATION.

WHITE COPY Environmental Health YELLOW COPY (Final) Owner / Applicant PINK COPY (Initial) Owner / Applicant