IREDELL COUNTY HEALTH DEPARTMENT

STATESVILLE 704-878-5305 MOORESVILLE 704-664-5281

51577

IMPROVEMENT PERMIT / CERTIFICATE OF COMPLETION / OPERATION PERMIT / EXISTING SYSTEM INSPECTION

PROPERTY DESCRIPTION NO. 18120 DATE 3/28/94 TAX MAP NO. 14K-A-94 (PART OF) Watershed: ☐ Yes ☒ No

OWNER OR CONTRACTOR TODD DISHMAN PHONE: Business Home 871-6035

ADDRESS RT-18, BOX 423-A, STVL, NC 28677

LOCATION NC 115 N, TL PISGAH, TR 1576, TR 1575, TL 1578, TR 1577 ~ 0.9 MILE ON (R), BACK OFF RD.

SUBDIVISION BLOCK / SECTION LOT LOT AREA AMPLE SITE CLASS. PS' DESIGN FLOW 360 L.T.A.R. 0.35 GPD/FT2

Septic Tank: 1000 Gallons; STB 1012 Date 3/15/94

Pump Tank: Gallons; PT Date

Pump Make: Model Serial No.

Nitrification Field: No Fields 1 Square Feet 1035 Linear Feet 345

No Lines 3 Trench Width 36" Max Trench Bottom Depth 18-36" Gravel Depth 12"

☒ New System ☐ Repair System Type: I, (II), III, IV, V, VI

System Description: CONV. GRAVITY

Repair System Description: CONV. GRAVITY

Maintenance Agreement Required: ☐ Yes ☒ No

☒ House/Mod. Home No. Bedrooms 3

☒ Mobile Home No. Bathrooms 2

☐ Business No. Employees

☐ Other


☐ Slab ☒ Crawl Space ☐ Basement w/plumbing ☐ Basement wo/plumbing

Water Supply: ☒ Individual ☐ Community ☐ Public

Comments: (1) KEEP SYSTEM MINIMUM 5' FROM MH, 10' FROM PROPERTY LINE, 100' FROM WELL (2) INSTALL SUBSURFACE INTERCEPT DRAIN AT LOCATION SHOWN, START 4' DEEP TO DAYLIGHT

Comments:

INITIAL SITE SKETCH

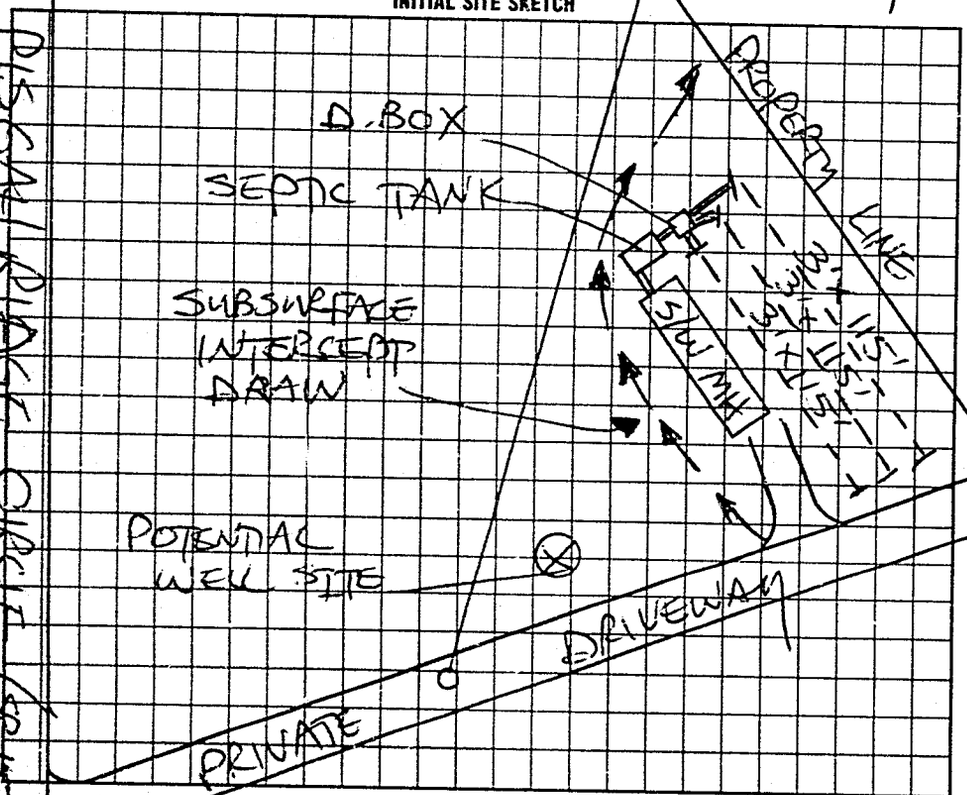

AS BUILT SKETCH

SYSTEM INSTALLED ACCORDING TO INITIAL SITE SKETCH

I understand that this permit can be suspended or revoked if any false information is supplied toward securing the permit/any unauthorized changes are made to the site/any unauthorized changes are made in the installation of the system. Improvement Permit is valid for 60 months from date of issuance.

Signed: X James Todd Dishman

Improvement Permit by: STEVE HEDRICK date 3/28/94

Existing System Inspection by: date

Installed by: KENNY PEARSON

Certificate of Completion by: STEVE HEDRICK date 6/7/94

Operation Permit by: date

HEALTH DEPT. COPY: WHITE INSPECTION COPY (FINAL): GREEN OWNER COPY (FINAL). YELLOW INSPECTION COPY (INITIAL): PINK OWNER COPY (INITIAL): GOLD