IREDELL COUNTY HEALTH DEPARTMENT

STATESVILLE 704-878-5305 MOORESVILLE 704-664-5281

IMPROVEMENT PERMIT / CERTIFICATE OF COMPLETION / OPERATION PERMIT / EXISTING SYSTEM INSPECTION

PROPERTY DESCRIPTION NO. 25922 65473 DATE 1-16-97 PIN NO. 4719396821 (14K-A-32) Watershed: ☐ Yes ☑ No

OWNER OR CONTRACTOR TRACY L. BARNES PHONE: Business 876-6705 Home

ADDRESS 156 BARNES AIRSHIP DRIVE, STATESVILLE NC 28677

LOCATION NC115 N, TL DAMASCUS CH. RD, TR BARNES AIRSHIP DRIVE, ~500' BEYOND CVA ALONG CREEK

SUBDIVISION BLOCK / SECTION LOT LOT AREA 39.71 AC SITE CLASS PS DESIGN FLOW 240 L.T.A.R. 0.33 GPD/FT²

Septic Tank: 1000 Gallons; STB 1012 Date 1-1-99
Pump Tank: 1000 Gallons; PT 17 Date 2-2-99
Pump Make: HYDROMATIC Model SHEF 50A1 Serial No.
Nitrification Field: No Fields 1 Square Feet 720 Linear Feet 240
No Lines THREE Trench Width 36" Max Trench Bottom Depth 36" Gravel Depth 12"

☑ New System ☐ Repair System Type: I, II, III, IV, V, VI
System Description: CONVENTIONAL, PUMP
Repair System Description: CONV, PUMP
Maintenance Agreement Required: ☐ Yes ☑ No

☑ House/Mod. Home No. Bedrooms 1
☐ Mobile Home No. Bathrooms 1
☐ Business No. Employees
☐ Other


☐ Slab ☐ Crawl Space ☐ Basement w/plumbing ☐ Basement wo/plumbing

Water Supply: ☑ Individual ☐ Community ☐ Public WELL


Comments: ① KEEP SYSTEM MINIMUM 100' FROM WELL, 50' FROM CREEK ② INSTALL LINES ON CONTOUR AS FLAGGED ③ SEE ATTACHED SHEETS FOR PUMP & PRESSURE MANIFOLD REQUIREMENTS

Comments: Drainlines inspected 3-2-99
Set pressure

INITIAL SITE SKETCH

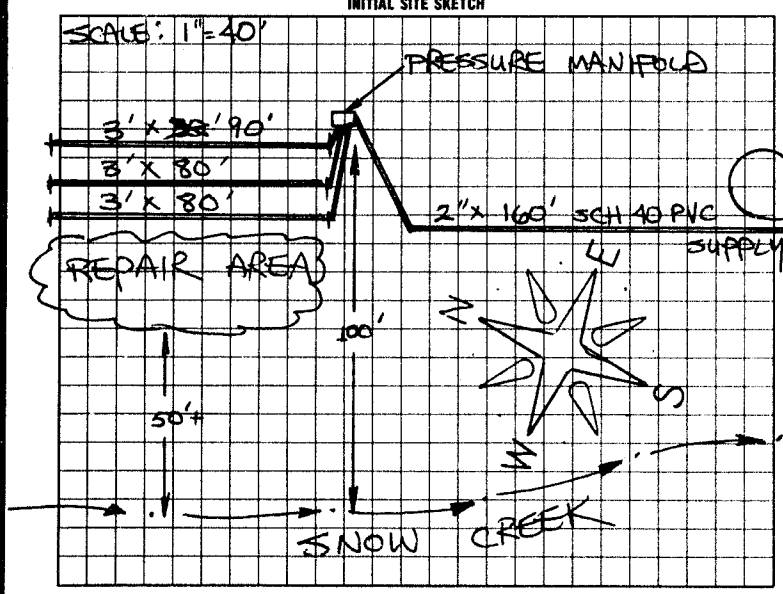

AS BUILT SKETCH

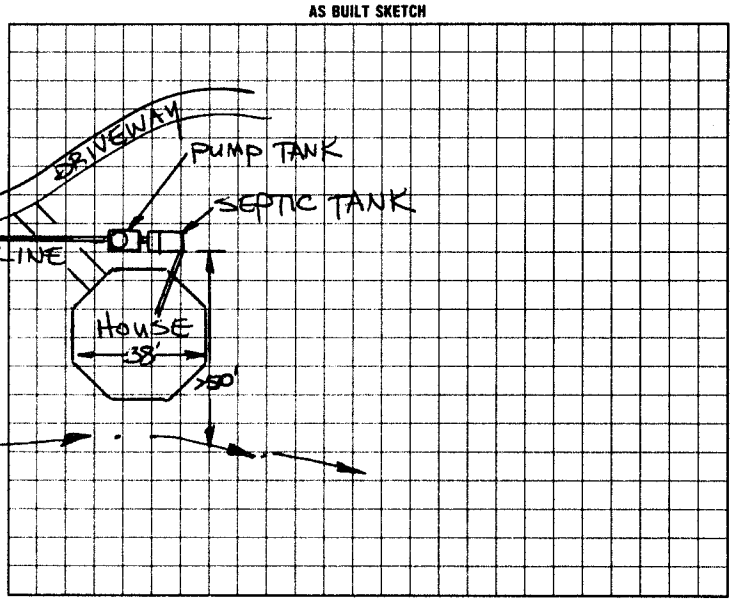

I understand that this permit can be suspended or revoked if any false information is supplied toward securing the permit/any unauthorized changes are made to the site/any unauthorized changes are made in the installation of the system. Improvement Permit is valid for 60 months from date of issuance. AUTHORIZATION TO CONSTRUCT IS VALID FOR 60 MONTHS FROM DATE OF ISSUANCE.

Signed: X Tracy Barnes

Installed by: KENNY MADISON

Improvement Permit by: STEVE HEDRICK date 1-16-97

Certificate of Completion by: date

AUTHORIZATION TO CONSTRUCT

Existing System Inspection by: STEVE HEDRICK date 1-16-97

Operation Permit by: STEVE HEDRICK date 5-3-99

HEALTH DEPT. COPY: WHITE INSPECTION COPY (FINAL): GREEN OWNER COPY (FINAL): YELLOW INSPECTION COPY (INITIAL): PINK OWNER COPY (INITIAL): GOLD