IREDELL COUNTY HEALTH DEPARTMENT

STATESVILLE 704-878-5305 MOORESVILLE 704-664-5281

IMPROVEMENT PERMIT / CERTIFICATE OF COMPLETION / OPERATION PERMIT / EXISTING SYSTEM INSPECTION

PROPERTY DESCRIPTION NO. 068015 DATE 7-9-97 TAX MAP NO. 4719408804 Watershed: ☐ Yes ☐ No

OWNER OR CONTRACTOR Ray L Dellinger PHONE: Business Home 876-2896

ADDRESS 602 Pisgah Church Rd Statesville NC

LOCATION 3004 115N TL Pisgah Church TR Bowles Farm, 8 miles on Rt 304 Bowles Farm

SUBDIVISION BLOCK / SECTION LOT LOT AREA 2.53 SITE CLASS. 0/5 DESIGN FLOW 360 L.T.A.R. .03

Septic Tank: 1000 Gallons; STB Date

Pump Tank: Existing Gallons; PT Date

Pump Make: Model Serial No.

Nitrification Field: No Fields 1 Square Feet Linear Feet 150

No Lines 1 Trench Width 36in Max Trench Bottom Depth 36in Gravel Depth 12

☒ New System ☐ Repair System Type: I, II, III, IV, V, VI

System Description: Gravity Conventional

Repair System Description:

Maintenance Agreement Required: ☐ Yes ☐ No

☐ House/Mod. Home ☒ Mobile Home ☐ Business ☐ Other

No. Bedrooms 3 No. Bathrooms 2 No. Employees

☐ Slab ☒ Crawl Space ☐ Basement w/plumbing ☐ Basement wo/plumbing


Water Supply: ☒ Individual ☐ Community ☒ Public

Comments:


- Keep lines on contour, 9ft on center
- System Needs to be Flagged - area grown over

Comments:

INITIAL SITE SKETCH

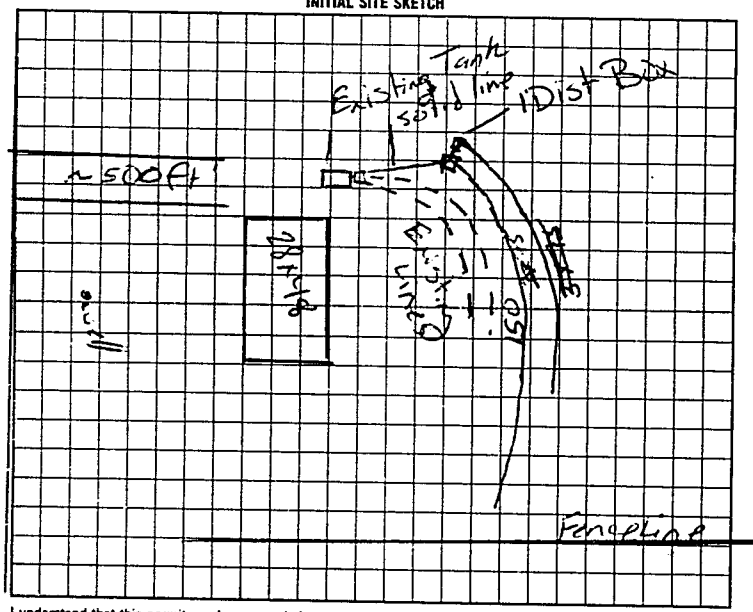

AS BUILT SKETCH

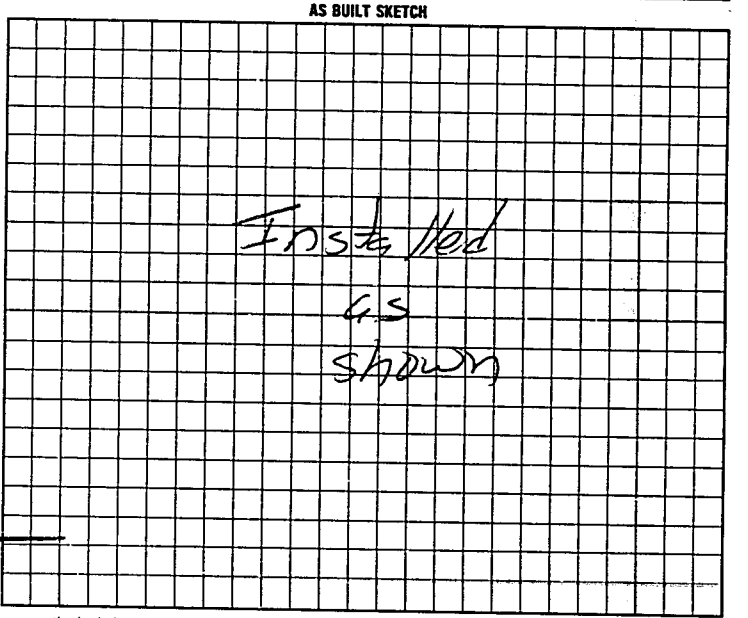

I understand that this permit can be suspended or revoked if any false information is supplied toward securing the permit/any unauthorized changes are made to the site/any unauthorized changes are made in the installation of the system. Improvement Permit is valid for 60 months from date of issuance.

Signed: Roy Dellinger

Improvement Permit by: Mark C. Ott RS date 7-9-97

Existing System Inspection by: Mark C. Ott RS date 7-9-97

Installed by: A-1 Backhoe

Certificate of Completion by: date

Operation Permit by: Mark C Ott RS date 8-5-97

HEALTH DEPT COPY WHITE INSPECTION COPY (FINAL) GREEN OWNER COPY (FINAL) YELLOW INSPECTION COPY (INITIAL) PINK OWNER COPY (INITIAL) GOLD