# IREDELL COUNTY HEALTH DEPARTMENT

STATESVILLE 704-878-5305 (C1) MOORESVILLE 704-664-5281

## IMPROVEMENT PERMIT / AUTHORIZATION TO CONSTRUCT / OPERATION PERMIT / EXISTING SYSTEM INSPECTION

PERMIT# 125347 PIN# 4719-41-2576 0114 DATE 12/22/04

OWNER OR CONTRACTOR Aaron Fox PHONE: Business Home (704) 876-2146

ADDRESS 318 Bowles Farm Road Statesville, N.C. 28625

LOCATION Hwy 115 N., Left on Pisgah Rd, Right on Bowles Farm Rd, 6th House on left @ 307 Bowles Farm Rd

SUBDIVISION — BLOCK / SECTION — LOT — LOT AREA 1.994 Ac. SITE CLASS. P5 DESIGN FLOW 360 L.T.A.R. .25 gpd/ft²

Septic Tank: 1,000 Gallons; STB 1007 Date 6-17-05
Pump Tank: Gallons; PT Date
Pump Make: Model Serial No.
Nitrification Field: No Fields 1 Square Feet 1440 Linear Feet 480
No Lines 4 Trench Width 36" Max Trench Bottom Depth 30" Gravel Depth 12"

☒ New System ☐ Repair System Type: I, (II), III, IV, V, VI
System Description: Gravity, Conventional
Repair System Description: Same
Maintenance Agreement Required: ☐ Yes ☒ No


☒ House/Mod. Home No. Bedrooms 3
☐ Mobile Home No. Bathrooms
☐ Business No. Employees
☐ Other
☐ Slab ☐ Crawl Space ☐ Basement w/plumbing ☒ Basement wo/plumbing

Water Supply: ☒ Individual ☐ Public ☐ Community

Comments:/Conditions: ① Keep well 100ft from Septic System
② Keep Septic Tank 16' off House

Comments:/Conditions: SEPTIC TANK WITH A MARKER INSTALLED USING "ZABEL" FILTER

INITIAL SITE SKETCH 1" = 100'

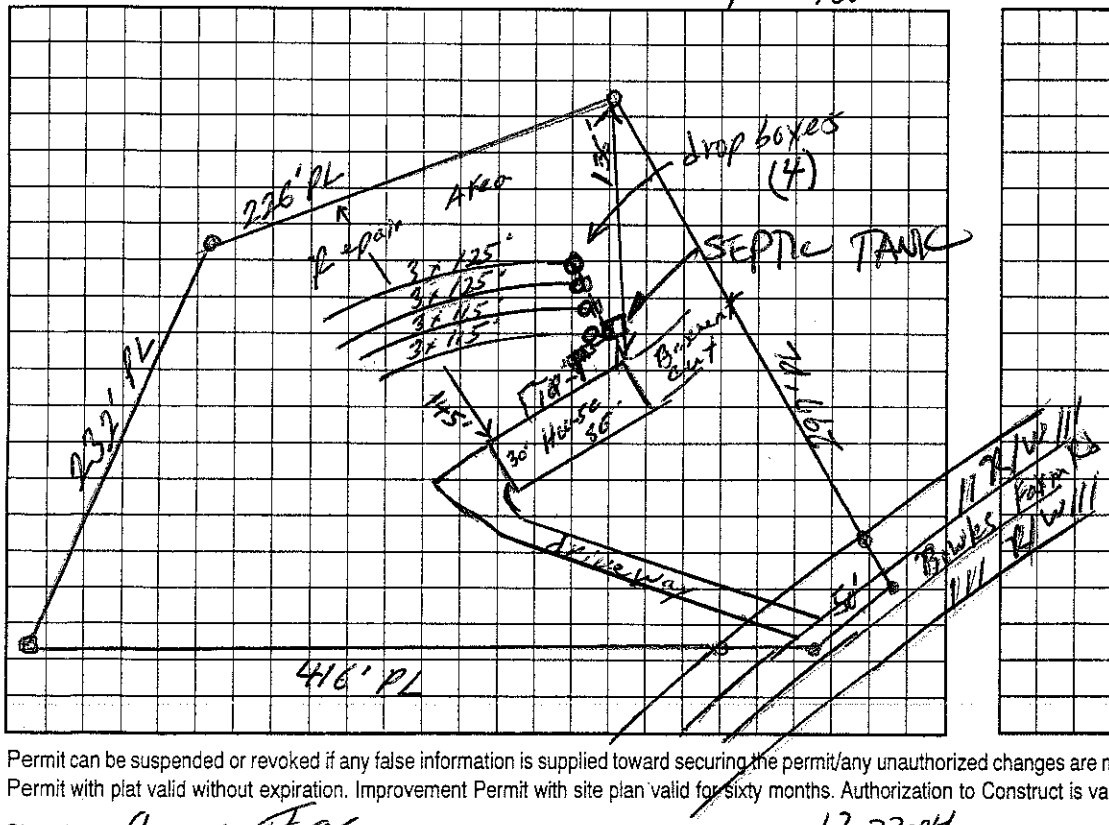


AS BUILT SKETCH

SYSTEM INSTALLED ACCORDING TO INITAL SITE SKETCH

Permit can be suspended or revoked if any false information is supplied toward securing the permit/any unauthorized changes are made to the site/any unauthorized changes are made in the installation of the system. Improvement Permit with plat valid without expiration. Improvement Permit with site plan valid for sixty months. Authorization to Construct is valid for a period equal to that of Improvement Permit – not to exceed sixty months.

Signed: Aaron Fox date 12-23-04

Improvement Permit by: William O. Johnson date 12/22/04

Authorization to Construct by: William O. Johnson date 12/23/04

Installed by: JAMES HUDER

Operation Permit by: STEVE HENDRICK date 8-22-05

Existing System Inspection by: date

HEALTH DEPT. COPY: WHITE OWNER COPY (FINAL): YELLOW OWNER COPY (INITIAL): PINK