IREDELL COUNTY HEALTH DEPARTMENT - *ENVIRONMENTAL HEALTH* ☒ STATESVILLE OFFICE 704-878-5305 ☐ MOORESVILLE OFFICE 704-664-5281

IMPROVEMENT PERMIT / AUTHORIZATION TO CONSTRUCT / OPERATION PERMIT / EXISTING SYSTEM INSPECTION

PERMIT # 163286 PIN # 4719-49-~~2832~~ 3766 DATE 10-25-10

OWNER Tracy Barnes APPLICANT: Same PHONE: Home/Cell # Business # 704-876-2378

SITE ADDRESS 133 Barnes Airship Rd OWNER / APPLICANT ADDRESS 156 Barnes Airship Rd.

SITE DIRECTIONS ~~I-77~~ 115 N, left at Damascus Church, (1) at Barnes Airship on (L)

SUBDIVISION Barnes BLOCK / SECTION LOT # 2 LOT AREA 4.966 DESIGN FLOW 360 L.T.A.R. .3

Septic Tank 1000 Gallons: STB 1012 Date 4-13-10 ☒ New System ☐ Repair ☐ Expansion System Type I II (III) IV V VI

Pump Tank 1000 Gallons: P.T. 17 Date 10-19-10 System Description: Conventional Pump

Pump Make Model Serial # Repair System Description: Conventional Pump

No. Nitrification Fields: 1 No. Lines 4 Linear Feet 400 Maintenance Agreement Required ☐ YES ☒ NO


Trench Width 36 Max. Trench Bottom Depth 36 Gravel Depth 12 ☐ GRAVITY ☒ PRESSURE

☒ Residence No. Bedrooms 3 ☐ Business No. Persons ☐ Other No. Employees ☐ Slab ☒ Crawl Space ☐ Basement w/plumbing ☐ Basement w/o plumbing

Water Supply: ☒ Private ☐ Public ☐ Community

Comments / Conditions: An approved system may also be used

INITIAL SITE SKETCH

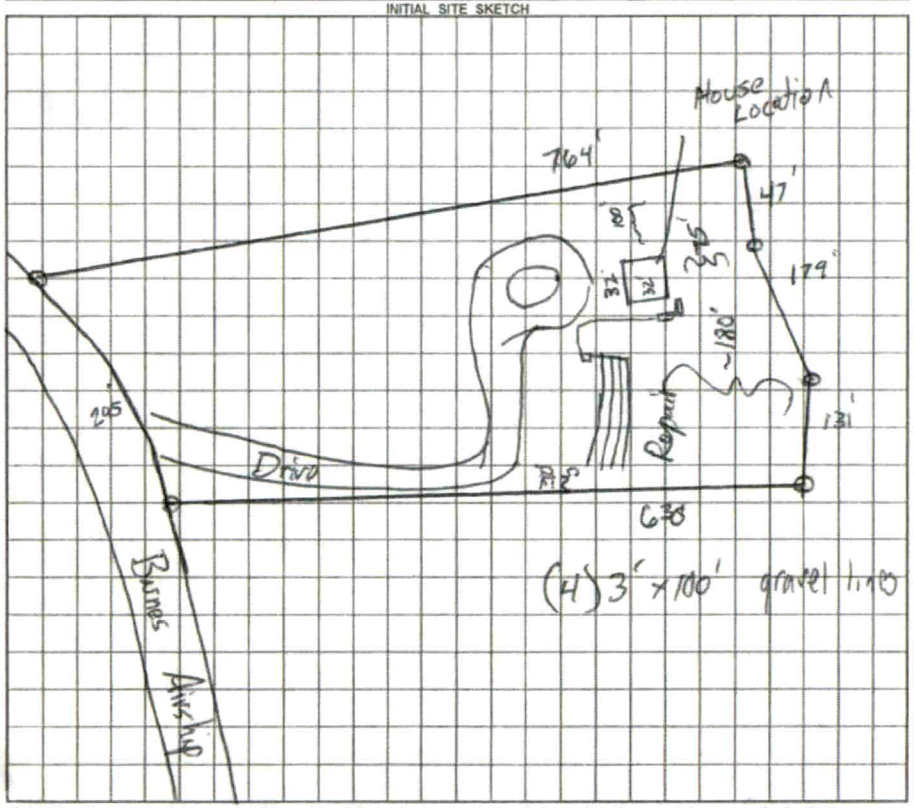

AS BUILT SKETCH

	Date	Initials
Drain Lines Checked	12-7	JS
Tanks Checked	12-6	TH
Pressure Manifold or Valve Box Checked	12-7	JS
Pressure Head Set	8/11/23	CW
Electrical Checked	8/11/23	CW
Floats Set	8/11/23	CW
Alarm Checked	8/11/23	CW
Maintenance Contract Y (N)		

Permit can be suspended or revoked if any false information is supplied toward securing the permit / any unauthorized changes are made to the site / any unauthorized changes are made in the installation of the system.

☐ ***IMPROVEMENT PERMIT*** *with plat valid without expiration.* ☒ ***IMPROVEMENT PERMIT*** *with ~~plat~~ valid ~~without expiration~~ site plan for 60 mos.* ☒ ***AUTHORIZATION TO CONSTRUCT*** valid for period equal to IMPROVEMENT PERMIT--not to exceed 60 mo.

Owner / Applicant Signature: Tracy Barnes Date 10-29-10 Installed by: License Installer

IMPROVEMENT PERMIT by: REHS Date 10-25-10 OPERATION PERMIT by: REHS Date 8/15/23

AUTHORIZATION TO CONSTRUCT by: REHS Date 10-29-10 Existing System Inspected by: REHS Date

YOU SHOULD CONTACT A LOCATOR SERVICE PRIOR TO ANY EXCAVATION

White Copy – Environmental Health YELLOW COPY (Final) Owner / Applicant PINK COPY (Initial) Owner / Applicant

IREDELL COUNTY HEALTH DEPARTMENT - *ENVIRONMENTAL HEALTH* ☒ STATESVILLE OFFICE 704-878-5305 ☐ MOORESVILLE OFFICE 704-664-5281

IMPROVEMENT PERMIT / AUTHORIZATION TO CONSTRUCT / OPERATION PERMIT / EXISTING SYSTEM INSPECTION

PERMIT # 163286 PIN # 4719-49-~~2832~~ 3766 DATE 10-25-10

OWNER Tracy Barnes APPLICANT: Same PHONE: Home/Cell # Business # 704-876-2378

SITE ADDRESS 133 Barnes Airship Rd. OWNER / APPLICANT ADDRESS 156 Barnes Airship Rd.

SITE DIRECTIONS 115 N, left at Damascus Church, (R) at Barnes Airship on (L)

SUBDIVISION Barnes BLOCK / SECTION LOT # 2 LOT AREA 4.966 DESIGN FLOW 360 L.T.A.R .3

Septic Tank 1000 Gallons: STB 1012 Date 4-13-10
Pump Tank 1000 Gallons: P.T. 17 Date 10-19-10
Pump Make Model Serial #
No. Nitrification Fields: 1 No. Lines 4 Linear Feet 400
Trench Width 36 Max. Trench Bottom Depth 36 Gravel Depth 12


☒ New System ☐ Repair ☐ Expansion System Type I II (III) IV V VI
System Description: Conventional Pump
Repair System Description: Conventional Pump
Maintenance Agreement Required ☐ YES ☒ NO
☐ GRAVITY ☒ PRESSURE

☒ Residence No. Bedrooms 3
☐ Business No. Persons
☐ Other No. Employees
☐ Slab ☒ Crawl Space
☐ Basement w/plumbing ☐ Basement w/o plumbing

Water Supply: ☒ Private ☐ Public ☐ Community

Comments / Conditions: An approved system may also be used

INITIAL SITE SKETCH

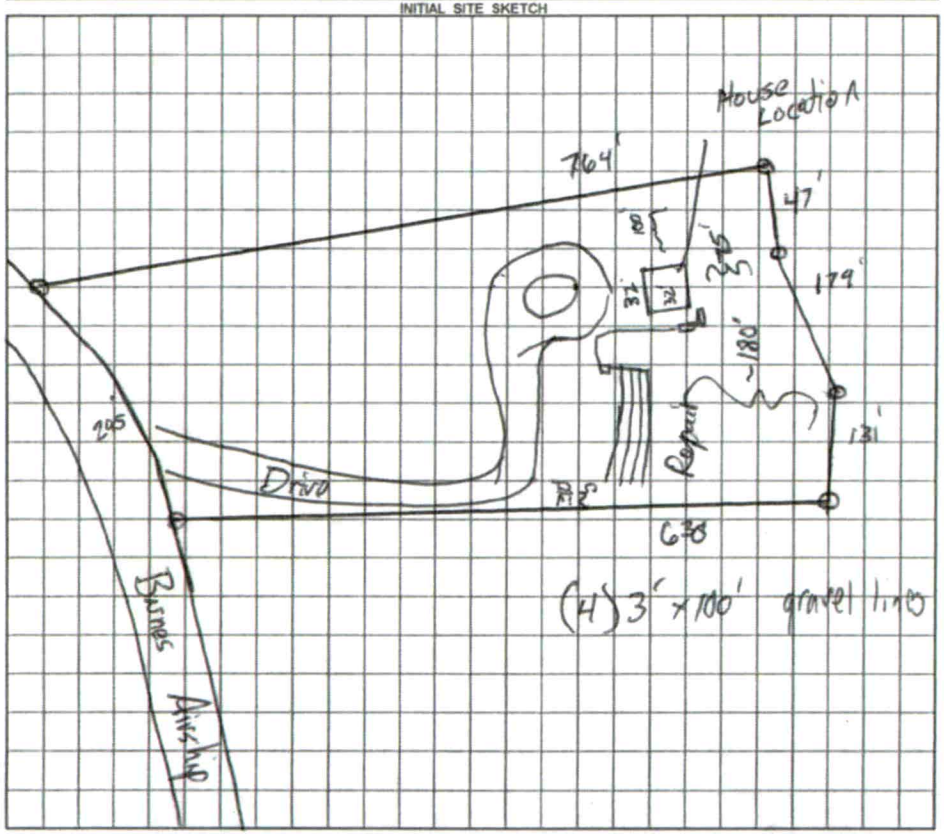

AS BUILT SKETCH

	Date	Initials
Drain Lines Checked	12-7	JS
Tanks Checked	12-6	TH
Pressure Manifold or Valve Box Checked	12-7	JS
Pressure Head Set		
Electrical Checked		
Floats Set		
Alarm Checked		
Maintenance Contract Y / N		

Permit can be suspended or revoked if any false information is supplied toward securing the permit / any unauthorized changes are made to the site / any unauthorized changes are made in the installation of the system.

☐ ***IMPROVEMENT PERMIT*** *with plat valid without expiration.* ☒ ***IMPROVEMENT PERMIT*** *with ~~plat~~ valid ~~without expiration~~ site plan for 60 mos.* ☒ ***AUTHORIZATION TO CONSTRUCT*** valid for period equal to IMPROVEMENT PERMIT--not to exceed 60 mo.

Owner / Applicant Signature: Tracy Barnes Date 10-29-10 Installed by:

IMPROVEMENT PERMIT by: REHS Date 10-25-10 OPERATION PERMIT by: REHS Date

AUTHORIZATION TO CONSTRUCT by: REHS Date 10-29-10 Existing System Inspected by: REHS Date

YOU SHOULD CONTACT A LOCATOR SERVICE PRIOR TO ANY EXCAVATION

White Copy – Environmental Health YELLOW COPY (Final) Owner / Applicant PINK COPY (Initial) Owner / Applicant