IREDELL COUNTY HEALTH DEPARTMENT

STATESVILLE 704-878-5305 MOORESVILLE 704-664-5281

IMPROVEMENT PERMIT / AUTHORIZATION TO CONSTRUCT / OPERATION PERMIT / EXISTING SYSTEM INSPECTION

PERMIT # 154343 PIN # 4719-51-4642 DATE 23 February 09

OWNER or APPLICANT Caleb Laws & Casey Fox PHONE: Business (704) 902-1597 Home:

OWNER or APPLICANT ADDRESS 460 Mt. Vernon Rd. Olin N.C.

LOCATION / DIRECTIONS 115N TL Pisgah Ch. Rd. TR Bowles Farm Rd. TR Fox Bottom - ON Rt. ND Corner.

SUBDIVISION BLOCK / SECTION LOT # LOT AREA DESIGN FLOW 360 g/d L.T.A.R. 0.3 g/d/ft²

Septic Tank 1000 Gallons: STB 1012 Date 4-28-08

Pump Tank Gallons: P T Date

Pump Make Model Serial #

Nitrification Field No Fields 1 No Lines 3 Linear Feet 300

Trench Width 36" Max. Trench Bottom Depth 36" Gravel Depth

☑ New System ☐ Repair ☐ Expansion System Type I II (III) IV V VI

System Description: 25% Reduction

Repair System Description: 25% Reduction

Maintenance Agreement Required ☐ YES ☑ NO

☑ GRAVITY ☐ PRESSURE

☑ Residence No. Bedrooms 3 ☐ Business No. Persons ☐ Other No. Employees ☐ Slab ☐ Crawl Space ☑ Basement w/plumbing ☐ Basement w/o plumbing

Water Supply: ☑ Private ☐ Public ☐ Community


Comments / Conditions: follow contour / Honor All setback requirements.

Comments / Conditions: ST has filter / ST has marker.

INITIAL SITE SKETCH

Please see Attached Site sketch

AS BUILT SKETCH

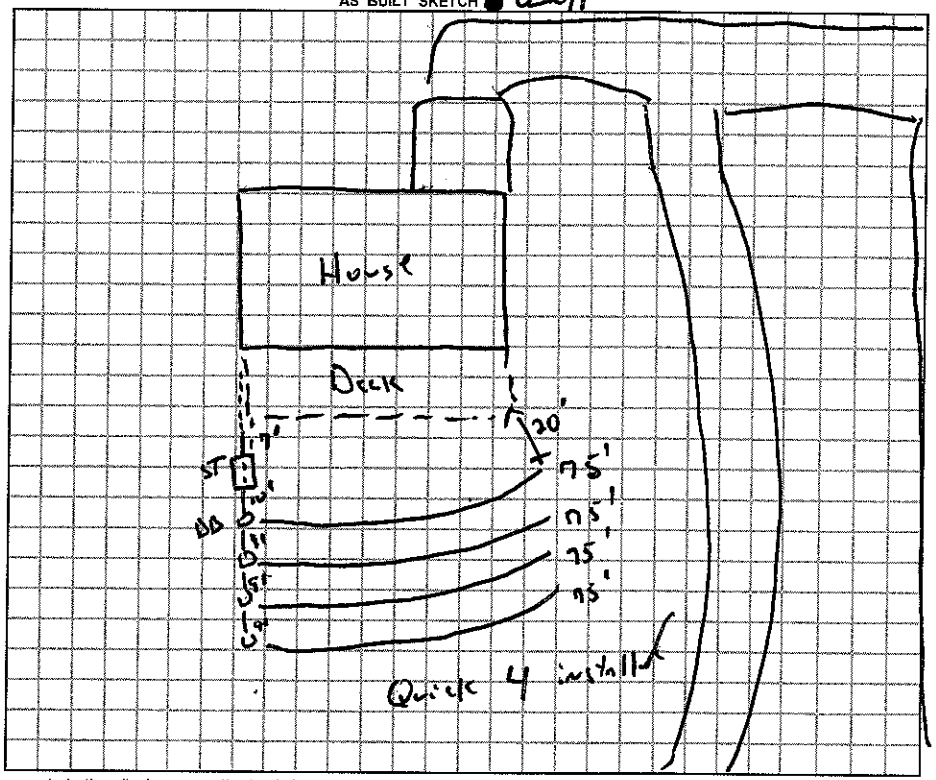

Permit can be suspended or revoked if any false information is supplied toward securing the permit / any unauthorized changes are made to the site / any unauthorized changes are made in the installation of the system.

☐ *IMPROVEMENT PERMIT w / plat valid without expiration.* ☑ *IMPROVEMENT PERMIT w / site plan valid for 60 mos.* ☑ *AUTHORIZATION TO CONSTRUCT valid for period equal to IMPROVEMENT PERMIT-not to exceed 60 mo.*

Owner / Applicant Signature: Date 2/25/09

Improvement Permit by: R.S. Date 24 Feb. 09

Authorization to Construct by: R.S. Date 24 Feb. 09

YOU SHOULD CONTACT A LOCATOR SERVICE PRIOR TO ANY EXCAVATION.

Installed by: James Hudlow

Operation Permit by: R.S. Date: 17 Aug. 09

Existing System Inspected by: Date:

WHITE COPY Environmental Health YELLOW COPY (Final) Owner / Applicant PINK COPY (Initial) Owner / Applicant