IREDELL COUNTY HEALTH DEPARTMENT

STATESVILLE 704-878-5305 MOORESVILLE 704-664-5281

IMPROVEMENT PERMIT / CERTIFICATE OF COMPLETION / OPERATION PERMIT / EXISTING SYSTEM INSPECTION

PROPERTY DESCRIPTION NO. 070481 DATE 12-4-97 TAX MAP NO. 4719660323 Watershed: ☐ Yes ☒ No

OWNER OR CONTRACTOR ERIC L. DIXON PHONE: Business Home 876-4526

ADDRESS 157 ERASTUS LANE, STATESVILLE, NC 28625

LOCATION NC 115 N, TL BOWLES FARM ROAD, TR ERASTUS LANE, 1ST LOT ON LEFT ~0.2MI

SUBDIVISION BLOCK / SECTION LOT LOT AREA 1.80 ACRES SITE CLASS P3 DESIGN FLOW 240 L.T.A.R. 0.30 SQ FT/FT²

Septic Tank: 1000 Gallons; STB Date

Pump Tank: Gallons; PT Date

Pump Make: Model Serial No.

Nitrification Field: No Fields 1 Square Feet 810 Linear Feet 270

No Lines THREE Trench Width 36" Max Trench Bottom Depth 36" Gravel Depth 12"

☒ New System ☐ Repair System Type: I, II, III, IV, V, VI

System Description: CONVENTIONAL GRAVITY

Repair System Description: CONVENTIONAL PUMP

Maintenance Agreement Required: ☐ Yes ☒ No

☐ House/Mod. Home ☒ Mobile Home ☐ Business ☐ Other

No. Bedrooms 3 No. Bathrooms 1 No. Employees


☐ Slab ☒ Crawl Space ☐ Basement w/plumbing ☐ Basement wo/plumbing

Water Supply: ☒ Individual ☐ Community ☐ Public WELL


Comments: KEEP SYSTEM MINIMUM 100' FROM WELL

Comments: * Tank lids will be exposed Owner to cut back down

INITIAL SITE SKETCH

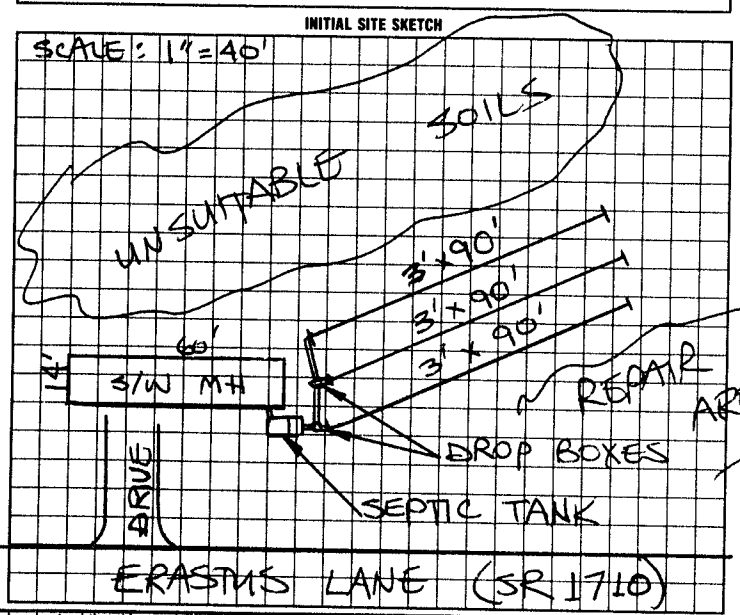

AS BUILT SKETCH

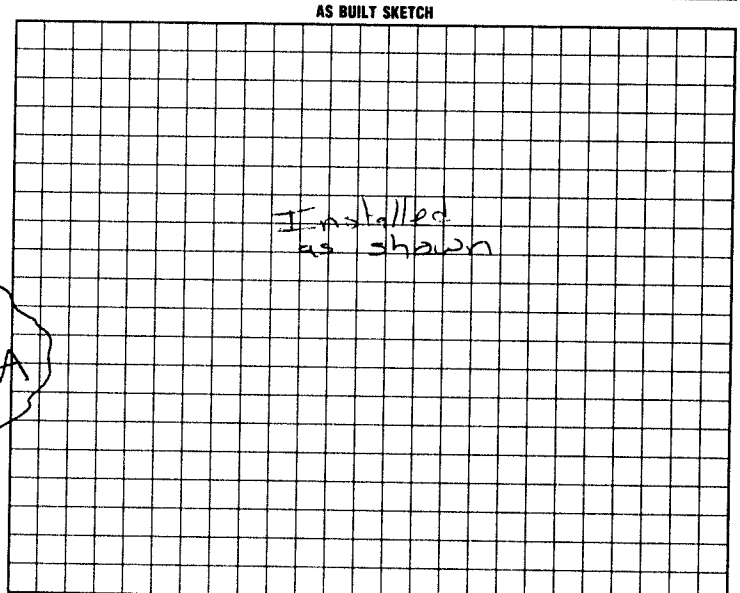

I understand that this permit can be suspended or revoked if any false information is supplied toward securing the permit/any unauthorized changes are made to the site/any unauthorized changes are made in the installation of the system. Improvement Permit is valid for 60 months from date of issuance. AUTHORIZATION TO CONSTRUCT IS VALID FOR 60 MONTHS FROM DATE OF ISSUANCE.

Signed: ERIC L. DIXON

Improvement Permit by: STEVE HEDRICK date 12-4-97

~~Existing System Inspection~~ AMDA: TO CONST. by: STEVE HEDRICK date 12-4-97

Installed by: CJW

~~Certificate of Completion~~ by: date

Operation Permit by: date 4-6-99

HEALTH DEPT. COPY: WHITE INSPECTION COPY (FINAL): GREEN OWNER COPY (FINAL): YELLOW INSPECTION COPY (INITIAL): PINK OWNER COPY (INITIAL): GOLD