IREDELL COUNTY HEALTH DEPARTMENT

STATESVILLE 704-878-5305 MOORESVILLE 704-664-5281

IMPROVEMENT PERMIT / CERTIFICATE OF COMPLETION / OPERATION PERMIT / EXISTING SYSTEM INSPECTION

PROPERTY DESCRIPTION NO. 17577 DATE 12/13/93 TAX MAP NO. 14K-A-92 Watershed: ☐ Yes ☑ No

OWNER OR CONTRACTOR ERIC LEE DIXON PHONE: Business Home 876-4526

ADDRESS Rt. 2, Box 61 STATESVILLE, NC 28677

LOCATION NC 115 N, TL BOWLES FARM ROAD, TR ERASTUS LANE, 1ST MH LOT ON (L)

SUBDIVISION ROBERT E. LONG BLOCK / SECTION LOT 3 LOT AREA 1.10 ACRES SITE CLASS. PS DESIGN FLOW 240 L.T.A.R. EXISTING

Septic Tank: EXISTING Gallons; STB Date

Pump Tank: Gallons; PT Date

Pump Make: Model Serial No.

Nitrification Field: No Fields Square Feet Linear Feet EXISTING

No Lines 2 Trench Width Max Trench Bottom Depth Gravel Depth

☑ New System ☐ Repair System Type: I (II) III, IV, V, VI

System Description: CONV. GRAVITY

Repair System Description:

Maintenance Agreement Required: ☐ Yes ☑ No

☐ Slab ☑ Crawl Space ☐ Basement w/plumbing ☐ Basement wo/plumbing

☐ House/Mod. Home No. Bedrooms 2

☑ Mobile Home No. Bathrooms 1

☐ Business No. Employees

☐ Other


Water Supply: ☑ Individual ☐ Community ☐ Public

Comments:

Comments: (1) KEEP SYSTEM MINIMUM 5' FROM M.H.

INITIAL SITE SKETCH

AS BUILT SKETCH

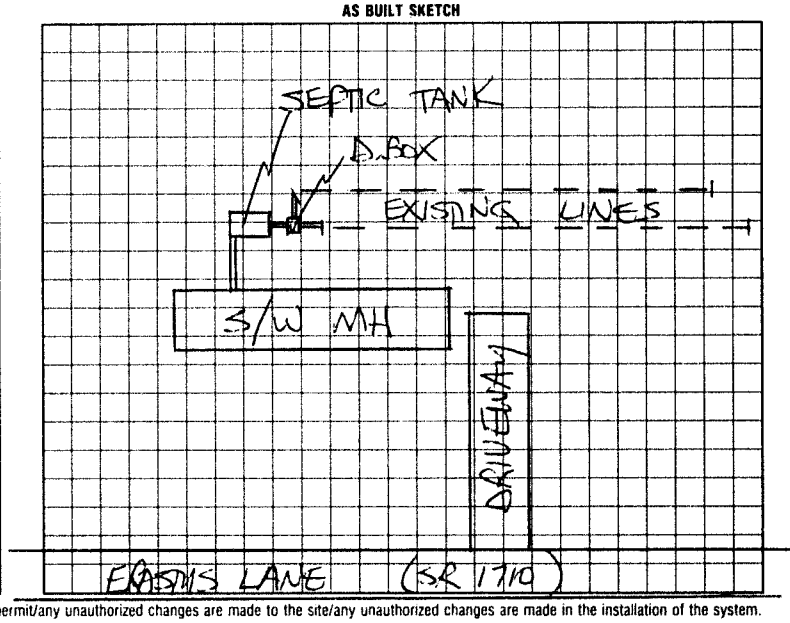

I understand that this permit can be suspended or revoked if any false information is supplied toward securing the permit/any unauthorized changes are made to the site/any unauthorized changes are made in the installation of the system. Improvement Permit is valid for 60 months from date of issuance.

Signed:

Improvement Permit by: date

Existing System Inspection by: STEVE HEDRICK date 12/13/93

Installed by:

Certificate of Completion by: date

Operation Permit by: date

HEALTH DEPT. COPY: WHITE INSPECTION COPY (FINAL): GREEN OWNER COPY (FINAL): YELLOW INSPECTION COPY (INITIAL): PINK OWNER COPY (INITIAL): GOLD