IREDELL COUNTY HEALTH DEPARTMENT

STATESVILLE 704-878-5305 MOORESVILLE 704-664-5281

IMPROVEMENT PERMIT / CERTIFICATE OF COMPLETION / OPERATION PERMIT / EXISTING SYSTEM INSPECTION

PROPERTY DESCRIPTION NO. 25475 DATE 11-18-96 TAX MAP NO. 14F - A - 17 (PART of) Watershed: ☐ PA ☐ No

OWNER OR CONTRACTOR DAVID COSEY PHONE: Business Home 876-0927

ADDRESS 3437 WILKESBORO HIGHWAY STATESVILLE, NC 28677

LOCATION NC 115 N, TL HILL DAIRY ROAD (1ST) 1ST D/W MH SITE PAST FOX BOTTOM ROAD ON (R)

SUBDIVISION BLOCK / SECTION LOT LOT AREA 1.1572Ac SITE CLASS. PS DESIGN FLOW 360 L.T.A.R. 0.30 GPD/FT²

Septic Tank: 1000 Gallons; STB 794 Date 10-31-96

Pump Tank: Gallons; PT Date

Pump Make: Model Serial No.

Nitrification Field: No Fields ☐ Square Feet 1200 Linear Feet 400

No Lines FIVE Trench Width 36" Max Trench Bottom Depth 36" Gravel Depth 12"

☑ New System ☐ Repair System Type: I, II, III, IV, V, VI

System Description: CONVENTIONAL GRAVITY

Repair System Description: CONV. GRAVITY

Maintenance Agreement Required: ☐ Yes ☑ No

☐ House/Mod. Home ☑ Mobile Home ☐ Business ☐ Other

No. Bedrooms 3 No. Bathrooms 2 No. Employees


☐ Slab ☑ Crawl Space ☐ Basement w/plumbing ☐ Basement wo/plumbing

Water Supply: ☑ Individual ☐ Community ☐ Public WELL

Comments: ① USE TWO DIST. BOXES FOR SERIAL DISTRIBUTION ② KEEP SYSTEM MINIMUM 100' FROM WELL

Comments:

INITIAL SITE SKETCH

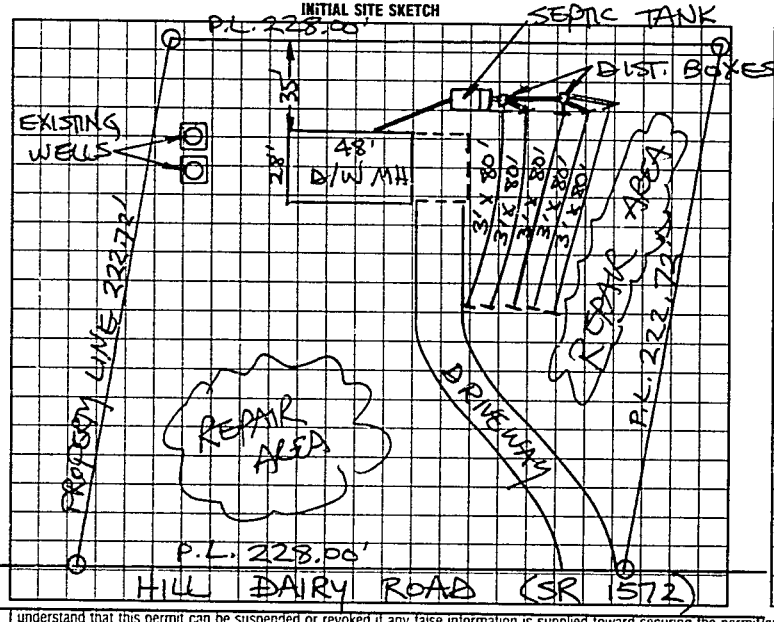

AS BUILT SKETCH

SYSTEM INSTALLED ACCORDING TO INITIAL SITE SKETCH

I understand that this permit can be suspended or revoked if any false information is supplied toward securing the permit any unauthorized changes are made to the site/any unauthorized changes are made in the installation of the system.

Auth. to Const., is valid for a period equal to the validity of the IP not to exceed five years. IP w/site plan is valid five years.

Signed: David Wayne Cosey

Improvement Permit by: STEVE HEDRICK date 11-18-96

Authorization to Construct ~~XXXXXXXXXX~~ by STEVE HEDRICK date 11-18-96

Installed by: JAMES HYDER

Certificate of Completion by: date

Operation Permit by STEVE HEDRICK date 12-16-96

HEALTH DEPT COPY WHITE INSPECTION COPY (FINAL) GREEN OWNER COPY (FINAL) YELLOW INSPECTION COPY (INITIAL) PINK OWNER COPY (INITIAL) BLUE